


15-163-20748-00-00

STATE OF KANSAS
STATE CORPORATION COMMISSION

WELL PLUGGING RECORD

Give All Information Completely
Make Required Affidavit
Mail or Deliver Report to
Conservation Division
State Corporation Comm.
245 North Water
Wichita, KS 67202

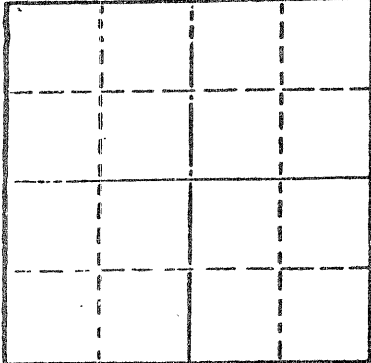

Locate well correctly on above
Section Plot

Rooks _____ County. Sec. 26 Twp. 8 Rge. 19 EE/W
Location as "NE/CNW $\frac{1}{4}$ SW $\frac{1}{4}$ " or footage from lines _____

C N $\frac{1}{2}$ - S $\frac{1}{2}$ - NW

Lease Owner J. B. Collins

Lease Name Veverka Well No. 5

Office Address 1007 Cody - Suite A, Hays, KS 67601

Character of Well (Completed as Oil, Gas or Dry Hole) _____
Dry Hole

Date Well completed 11-8 1977

Application for plugging filed 11-8 1977

Application for plugging approved 11-8 1977

Plugging commenced 11-8 1977

Plugging completed 11-8 1977

Reason for abandonment of well or producing formation _____

Dry Hole
If a producing well is abandoned, date of last production _____
19 _____

Was permission obtained from the Conservation Division or
its agents before plugging was commenced? yes

Name of Conservation Agent who supervised plugging of this well Gilbert Balthazor

Producing formation _____ Depth to top _____ Bottom _____ Total Depth of Well 3450'

Show depth and thickness of all water, oil and gas formations.

OIL, GAS OR WATER RECORDS

CASING RECORD

FORMATION	CONTENT	FROM	TO	SIZE	PUT IN	PULLED OUT
Surface Pipe				8 5/8"	214'	0

Describe in detail the manner in which the well was plugged, indicating where the mud fluid was placed and the method or methods used in introducing it into the hold. If cement or other plugs were used, state the character of same and depth placed, from _____ feet to _____ feet for each plug set.

1st plug was set @ 600' w/70 sacks

2nd plug was set @ 215' w/20 sacks

3rd plug was set @ 40' w/10 sacks

RECEIVED
STATE CORPORATION COMMISSION

NOV 15 1977

11/15/77

CONSERVATION DIVISION
Wichita, Kansas

(If additional description is necessary, use BACK of this sheet)

Name of Plugging Contractor Dreiling Oil, Inc.

STATE OF KANSAS COUNTY OF ELLIS, ss.

I, Joseph A. Hess, Sec. Treas. of Drlg. Contrc. (employee of owner) or (owner or operator) of the above-described well, being first duly sworn on oath, says: That I have knowledge of the facts, statements, and matters herein contained and the log of the above-described well as filed and that the same are true and correct. So help me God.

(Signature)

Joseph A. Hess
JOSEPH A. HESS, HAYS, KS 67601
(Address)

SUBSCRIBED AND SWORN TO before me this 14 day of November, 19 77

Cecilia Basgall
Cecilia Basgall Notary Public.

My commission expires November 17, 1980

CECILIA BASGALL
NOTARY PUBLIC
Ellis County, Kansas

DREILING OIL, INC.

Victoria, Kansas 67671

15-163-20748-00-00

WELL LOG

Company	J. B. Collins 1007 Cody - Suite A Hays, KS 67601	No. 5	Sec. 26	Twp. 8	Req. 19
Farm	Veverka		Location	C N $\frac{1}{2}$ - S $\frac{1}{2}$ - NW	
Total Depth	3,450'		County	Rooks	
Comm.	11-2-77	Comp. 11-8-77	Elevation:	1994	K. B.
Contractor	Dreiling Oil, Inc. Rt. #1 Victoria, KS 67671			1991	D. F.
				1989	G. R.

Casing Record
214' - 8 5/8"

Cement Record
140 sacks cement

Production:
D & A

Figures Indicate Bottom of Formations

0'	15'
15'	45'
45'	105'
105'	880'
880'	1121'
1121'	1399'
1399'	1433'
1433'	1890'
1890'	3038'
3038'	3450'
3450'	T.D.

Top Soil
Post Rock
Sand & Clay
Shale
Sand
Red Bed & Shale
Anhydrite
Shale
Shale & Lime
Lime

RECEIVED
CORPORATION COMMISSION
NOV 15 1977
CONSERVATION DIVISION
Wichita, Kansas

11/15/77

STATE OF KANSAS)
)ss
COUNTY OF ELLIS)

I, Joseph A. Hess, Secretary Treasurer of Dreiling Oil, Inc., upon oath states that the above and foregoing is a true and correct copy from the Daily Drilling Report from the Veverka #5.


JOSEPH A. HESS

Subscribed and sworn to before me this 14th day of November, 1977.


Cecilia Basgall Notary Public

My appointment expires: November 17, 1980.

CECILIA BASGALL
NOTARY PUBLIC
Ellis County, Kansas