


STATE OF KANSAS
STATE CORPORATION COMMISSION

Give All Information Completely
Make Required Affidavit
Mail or Deliver Report to:
Conservation Division
State Corporation Commission
800 Bittling Building
Wichita, Kansas

15-163-19155-00-00
WELL PLUGGING RECORD

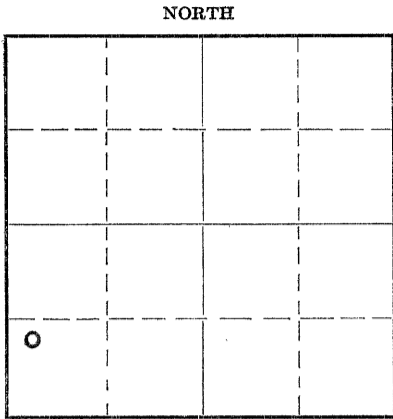

Locate well correctly on above Section Plat

Rooks County. Sec. 26 Twp. 8S Rge. 19XX (W)
Location as "NE/CNW $\frac{1}{4}$ SW $\frac{1}{4}$ " or footage from lines NW SW SW
Lease Owner SHELL OIL COMPANY
Lease Name F. VEVERKA "B" Well No. 1
Office Address Box 744, Great Bend, Kansas
Character of Well (completed as Oil, Gas or Dry Hole) Dry Hole
Date well completed October 8 19 46
Application for plugging filed November 18 19 49
Application for plugging approved November 19 19 49
Plugging commenced November 28 19 49
Plugging completed December 3 19 49
Reason for abandonment of well or producing formation Dry Hole

If a producing well is abandoned, date of last production - 19
Was permission obtained from the Conservation Division or its agents before plugging was commenced? Yes

Name of Conservation Agent who supervised plugging of this well Eldon Petty
Producing formation Arbuckle Depth to top 3407 Bottom Total Depth of Well 3414 Feet
Show depth and thickness of all water, oil and gas formations. 3236 PB

OIL, GAS OR WATER RECORDS

CASING RECORD

Formation	Content	From	To	Size	Put In	Pulled Out
Arbuckle	Swab scum oil -	3408	3414	13"	103'	None
	BS & 66 bbls			8 5/8"	1394'	None
	water 1 hour.			4 1/2"	3408'	2580'

Describe in detail the manner in which the well was plugged, indicating where the mud fluid was placed and the method or methods used in introducing it into the hole. If cement or other plugs were used, state the character of same and depth placed, from feet to feet for each plug set.

Filled hole with rock to 3150' & ran 3 sacks of cement. Mudded hole to 250'. Set bridge & ran 15 sacks of cement. Mudded hole to 30' & capped with 10 sacks of cement.

DEC 22 1949

12/22/49

(If additional description is necessary, use BACK of this sheet)


Correspondence regarding this well should be addressed to Shell Oil Company
Address c/o S. S. Mabry, Box 744, Great Bend, Kansas

STATE OF KANSAS, COUNTY OF BARTON, ss.
S. S. Mabry (employee of owner) or ~~owner~~ of the above-described well,
being first duly sworn on oath, says: That I have knowledge of the facts, statements, and matters herein contained and the log of the above-described well as filed and that the same are true and correct. So help me God.

(Signature) *S. S. Mabry*
Box 744, Great Bend, Kansas (Address)

SUBSCRIBED AND SWORN to before me this 20th day of December, 19 49

My commission expires January 24, 1953 Betty Pastethurite Notary Public.

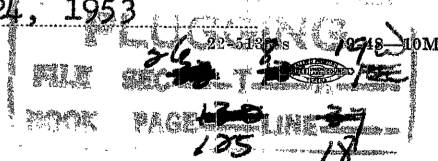

15-163-19/55-00-00

SHELL, F. VEVERKA "B" #1
NW SW SW Section 26-8S-19W
Webster Pool
Rooks County, Kansas

Casing Record

0 - 40 surface sand & clay
 145 shale & shells
 488 sticky shale
 535 shale
 805 sand & shale
 840 lime & pyrite
 900 lime, shale & pyrite
 1108 sand & shale
 1390 red rock & shale
 1450 anhydrite
 1495 red rock
 1550 sandy shale
 1675 shale
 1785 shale & shells, sandy
 1975 shale & lime
 2005 shale
 2017 lime
 2030 shale
 2050 lime
 2060 shale
 2234 lime & shale
 2294 lime
 2414 lime & shale
 2453 lime
 2519 lime & shale
 2570 lime
 2618 lime & shale
 3008 lime & shale Top Topeka 2911
 3060 lime
 3147 lime & shale Top Lansing-Kansas City 3140
 3406 lime
 3409 dolomite
 3409=3410 Top Arbuckle 3407
 3414 dolomite TD
 3236 PB

13" cem 103 with 110 sax & 2% Aquagel
 8 5/8" cem 1394 with 400 sax & 2% Aquagel
 4 1/2" cem 3408 with 125 sax; perforated
 3310-55, 3240-45 1/2, 3200-26, &
 3160-70.

NOV 19 1949

11/19/49

PLUGGING
 FILE SEC 26-8-19W
 BOOK PAGE 185 LINE 18