


STATE OF KANSAS  
STATE CORPORATION COMMISSION

Form CP-4

Give All Information Completely  
Make Required Affidavit  
Mail or Deliver Report to:  
Conservation Division  
State Corporation Commission  
P. O. Box 17027  
Wichita, Kansas 67217  
NORTH

WELL PLUGGING RECORD

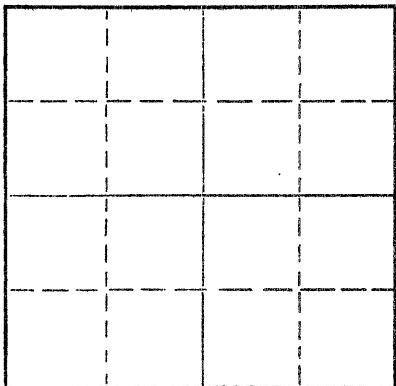

Locate well correctly on above  
Section Plat

Rooks \_\_\_\_\_ County. Sec. 27 Twp. 8 Rge. \_\_\_\_\_ (E) 19 (W) X  
Location as "NE/CNW/SW" or footage from lines S/2 NE/SW  
Lease Owner Clinton Oil Company  
Lease Name Stice J A Stice KCC Zap Well No. 3  
Office Address Box 404 Plainville, Kansas  
Character of Well (completed as Oil, Gas or Dry Hole) \_\_\_\_\_  
Date well completed \_\_\_\_\_ 19\_\_\_\_  
Application for plugging filed \_\_\_\_\_ 19\_\_\_\_  
Application for plugging approved \_\_\_\_\_ 19\_\_\_\_  
Plugging commenced \_\_\_\_\_ December 21, 1972  
Plugging completed \_\_\_\_\_ December 23, 1972  
Reason for abandonment of well or producing formation \_\_\_\_\_ Depleted

If a producing well is abandoned, date of last production \_\_\_\_\_ 19\_\_\_\_  
Was permission obtained from the Conservation Division or its agents before plugging was commenced? \_\_\_\_\_ Yes

Name of Conservation Agent who supervised plugging of this well Leo Massey  
Producing formation \_\_\_\_\_ Depth to top \_\_\_\_\_ Bottom \_\_\_\_\_ Total Depth of Well 3405 Feet  
Show depth and thickness of all water, oil and gas formations.

OIL, GAS OR WATER RECORDS

CASING RECORD

FORMATION	CONTENT	FROM	TO	SIZE	PUT IN	PULLED OUT
				8 5/8	1394	None
				5 1/2	3401	2346.43'

Describe in detail the manner in which the well was plugged, indicating where the mud fluid was placed and the method or methods used in introducing it into the hole. If cement or other plugs were used, state the character of same and depth placed, from \_\_\_\_\_ feet to \_\_\_\_\_ feet for each plug set.

Measured T.D. at 3380 ft. Pushed a plug to 3000 ft., dumped 25 ft. sand and 5 sacks cement. Shot casing at 3445 and 2340 ft. Pulled 65 jts. of 5 1/2" casing. Built a rock bridge at 750 ft. and dumped 3 yds. readymix cement, loaded hole with water and Built a rock bridge at 225 ft. and dumped 3 yds. readymix concrete.


RECEIVED  
STATE CORPORATION COMMISSION  
DEC 29 1972  
DEC 29 1972  
CONSERVATION DIVISION  
Wichita, Kansas

(If additional description is necessary, use BACK of this sheet)

Name of Plugging Contractor Rockhold Engineering, Inc.  
Address P. O. Box 698 Great Bend, Kansas 67530

STATE OF Kansas, COUNTY OF Barton, ss.  
James W. Rockhold (employee of owner) or (owner or operator) of the above-described well, being first duly sworn on oath, says: That I have knowledge of the facts, statements, and matters herein contained and the log of the above-described well as filed and that the same are true and correct. So help me God.

(Signature) James W. Rockhold James W. Rockhold  
Box 698 Great Bend, Ks. 67530 (Address)

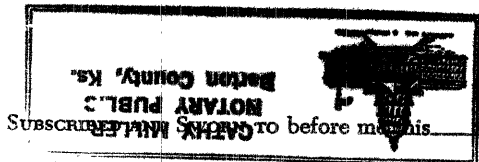

Subscribed and sworn to before me this 26th day of December, 1972

My commission expires September 30, 1975

Cathy Miller Notary Public.