


STATE OF KANSAS
STATE CORPORATION COMMISSION

Give All Information Completely
Make Required Affidavit
Mail or Deliver Report to:
Conservation Division
State Corporation Commission
800 Bitting Building
Wichita, Kansas

WELL PLUGGING RECORD

NORTH

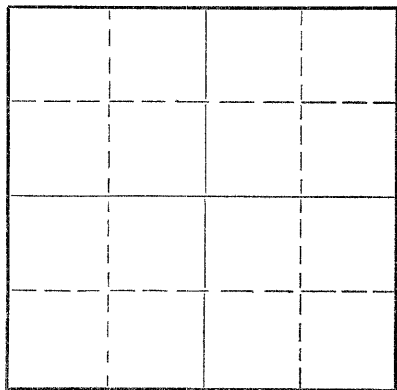

Locate well correctly on above
Section Plat

Rooks County. Sec. 27 Twp. 8 Rge. (E) 19 (W)

Location as "NE/CNW%SW%" or footage from lines NW 1/4 SE 1/4 SE 1/4

Lease Owner Barnett Oil Company

Lease Name Veverka "A" Well No. 1

Office Address 417 First Nat'l Bank Bldg., Wichita, Kansas

Character of Well (completed as Oil, Gas or Dry Hole) Oil

Date well completed December 17, 1950

Application for plugging filed January 28, 1953

Application for plugging approved January 28, 1953

Plugging commenced January 28, 1953

Plugging completed February 10, 1953

Reason for abandonment of well or producing formation Production will not justify operation of the well

If a producing well is abandoned, date of last production January 26, 1953

Was permission obtained from the Conservation Division or its agents before plugging was commenced? Yes

Name of Conservation Agent who supervised plugging of this well Eldon Petty

Producing formation K. C. Lime Depth to top 3134 Bottom 3177 Total Depth of Well 3382 Feet

Show depth and thickness of all water, oil and gas formations.

OIL, GAS OR WATER RECORDS

CASING RECORD

FORMATION	CONTENT	FROM	TO	SIZE	PUT IN	PULLED OUT
Surface Casing		-0-	165	8 5/8	165	None
Oil String		-0-	3379	5 1/2	3379	2316 ft.

Describe in detail the manner in which the well was plugged, indicating where the mud fluid was placed and the method or methods used in introducing it into the hole. If cement or other plugs were used, state the character of same and depth placed, from _____ feet to _____ feet for each plug set.

Plugged back depth of well per attached log 3224 feet.

Filled casing with sand from 3224 ft. to 3150 ft. and dumped 4 sacks of cement at 3150 ft. Pipe shot off at 2316 ft. Pumped 36 sacks of mud to break circulation and pulled pipe. Set plug at 245 feet and pumped 50 sacks of cement by Halliburton to 95 feet. Filled surface pipe with heavy mud from 95 feet to 15 feet and set bridge at 15 feet. Filled surface casing with 5 sacks of cement to top.

Feb 27, 1953

(If additional description is necessary, use BACK of this sheet)

Name of Plugging Contractor Bert Self

Address R. R. #14, Hutchinson, Kansas

STATE OF Kansas, COUNTY OF Sedgwick, ss.

W. R. Hunter (employee of owner) or (owner or operator)

well, being first duly sworn on oath, says: That I have knowledge of the facts, statements, and matters herein contained and the log of the above-described well as filed and that the same are true and correct. So help me God.

(Signature) W. R. Hunter

417 First Nat'l Bank Bldg., Wichita, Kansas


(Address)

SUBSCRIBED AND SWORN TO before me this 25th day of February, 1953

My commission expires February 27, 1956.

Mildred J. Willis

Notary Public.

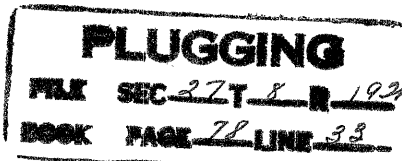

15-163 -1946-00-00

BARNETT OIL COMPANY, ET AL
LOG OF VEVERKA "A" WELL NO. 1
NW $\frac{1}{4}$ SE $\frac{1}{2}$ SE $\frac{1}{2}$ SECTION 27-8S-19W
ROOKS COUNTY, KANSAS

DATE COMMENCED: November 29, 1950

DATE COMPLETED: December 17, 1950

<u>Formation</u>	<u>From</u>	<u>To</u>	<u>Remarks</u>
Surface Clay	0	8	
Sand	8	28	
Shale and Shells	28	100	
Sand	100	110	
Shale and Shells	110	165	Set 8 5/8", 21# Surface Pipe at 165 feet; cemented with 125 sacks of cement.
Lime Shells	165	180	
Shale and Shells	180	630	
Sand	630	745	
Shale and Shells	745	1362	
Anhydrite	1362	1379	
Shale and Shells	1379	2810	
Lime and Shale	2810	2870	
Lime	2870	2980	
Lime and Shale	2980	3102	
Lime	3102	3175	
Lime and Shale	3175	3205	
Lime	3205	3382	Set 5 1/2", 17# Seamless Casing at 3379 feet; cemented with 150 sacks of cement.
Total Depth		3382	
Plugged Back to K.C. Lime Section - Plug set at		3224	Perforated 3164 to 3166 and 3175 to 3177, produced from K.C. section to January 26, 1953.

Feb 27, 1953

PLUGGING
 FILE SEC 27T 8 R 1934
 BOOK PAGE 28 LINE 33