

STATE OF KANSAS
STATE CORPORATION COMMISSION

Give All Information Completely
Make Required Affidavit
Mail Deliver Report to:
Conservation Division
State Corporation Commission
1001 No. Broadway
Wichita, Kansas

16
WELL PLUGGING RECORD

_____ Rook's _____ County. Sec. 27 Twp. 8-S Rge. 19-W (E) _____ (W)

Location as "NE/CNW/SW" or footage from lines NW SW SW

Lease Owner MORGENSTERN OIL OPERATION'S

Lease Name VEVERKA Well No. 11

Office Address P.O. Box 2526 Wichita 8, KANSAS

Character of Well (completed as Oil, Gas or Dry Hole) _____

Date well completed _____ 19__

Application for plugging filed _____ 19__

Application for plugging approved _____ 19__


Plugging commenced October 18, 1962 19__

Plugging completed October 26, 1962 19__

Reason for abandonment of well or producing formation _____

If a producing well is abandoned, date of last production _____ 19__

Was permission obtained from the Conservation Division or its agents before plugging was commenced? _____

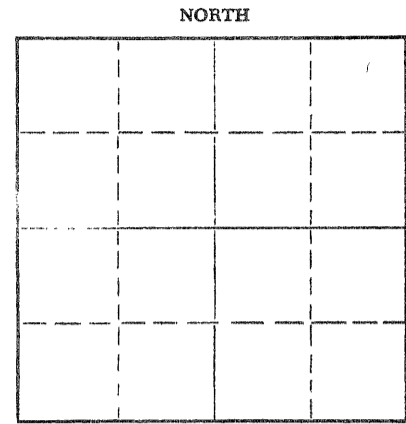

Locate well correctly on above Section Plat

Name of Conservation Agent who supervised plugging of this well Eldon Petty, Hays, Kansas

Producing formation _____ Depth to top _____ Bottom _____ Total Depth of Well _____ Feet

Show depth and thickness of all water, oil and gas formations.

OIL, GAS OR WATER RECORDS

CASING RECORD

FORMATION	CONTENT	FROM	TO	SIZE	PUT IN	PULLED OUT

Describe in detail the manner in which the well was plugged, indicating where the mud fluid was placed and the method or methods used in introducing it into the hole. If cement or other plugs were used, state the character of same and depth placed, from _____ feet to _____ feet for each plug set.

Plugged, back with sand to 3410 - feet, Dumped 4- sacks Cement.
Circulated Mud at 530- feet, Pumped 20- sacks Cement.
Pumped 20- sacks Cement at 180- feet.
Set a ten foot Rock Bridge at 40- feet, Dumped ten sacks Cement.

RECEIVED
STATE CORPORATION COMMISSION
NOV 6 1962
NOV 6 1962
CONSERVATION DIVISION
Wichita, Kansas

(If additional description is necessary, use BACK of this sheet)

Name of Plugging Contractor LYNCH CASING PULLING COMPANY. NO. 457

Address R. RT. 4 GREAT BEND, KANSAS

STATE OF _____, COUNTY OF _____, ss.

_____ (employee of owner) or (owner or operator) of the above-described well, being first duly sworn on oath, says: That I have knowledge of the facts, statements, and matters herein contained and the log of the above-described well as filed and that the same are true and correct. So help me God.

(Signature) Arthur Morgenstern

P.O. Box 2526 Wichita 8
(Address)

SUBSCRIBED AND SWORN TO before me this 5th day of November 1962

My commission expires July 5, 1966

Marilyn J. Rose
Notary Public.



DRILLER'S LOG

Company: Peel-Hardman Oil Operators

Location: NW SW SW
Sec. 27, Twp. 8S, Rge. 19W

Farm: Veverka Well No. 11

Comm.: 4-29-60 Comp.: 5-6-60

County: Rooks,
Kansas

Total Depth: 3418'

Contractor: Glenn W. Peel Drilling Co.

Elevation:

Casing: 8 5/8" @ 162' cem.
5 1/2" @ 3417' cem.

Production:

Figures below indicate bottom of formations

Surface Clay	0-	40'
Shale		430
Shale & Shells		875
Sand		1115
Shale & Red Bed		1295
Red Bed		1410
Anhydrite		1450
Shale & Shells		1655
Shale & Lime		2685
Shale		2775
Shale & Lime		3220
Lime		3416
Arbuckle		3418
Total Depth		3418

RECEIVED
STATE CORPORATION COMMISSION
OCT 8, 1962
OCT 8, 1962
CONSERVATION DIVISION
Wichita, Kansas

This is to certify that the above information is to the best of my knowledge true and correct.

GLENN W. PEEL DRILLING COMPANY

BY: W. Herbert

SUBSCRIBED AND SWORN TO before me this-20th day of May, 1960.

My commission expires March 4, 1962.

Marion M. Herbert
Notary Public