


15-163-01406-00-00

STATE OF KANSAS  
STATE CORPORATION COMMISSION

WELL PLUGGING RECORD

Give All Information Completely  
Make Required Affidavit  
Mail or Deliver Report to:  
Conservation Division  
State Corporation Commission  
800 Bittling Building  
Wichita, Kansas

Rooks County, Sec. 27 Twp. 8 Rge. 19 (W)  
Location as "NE/CNW 1/4 SW 1/4" or footage from lines SW NW NW  
Lease Owner Northern Pump Co.  
Lease Name Green "A" Well No. 4  
Office Address Box 317, Great Bend, Kansas  
Character of Well (completed as Oil, Gas or Dry Hole) Oil  
Date well completed 8-15 19.48  
Application for plugging filed 5-6 19.49  
Application for plugging approved 5-9 19.49  
Plugging commenced 5-7 19.49  
Plugging completed 5-14 19.49  
Reason for abandonment of well or producing formation Production Down  
to 2 barrels oil and 98 barrels water per day.  
If a producing well is abandoned, date of last production April 30 19.49  
Was permission obtained from the Conservation Division or its agents before plugging was commenced? Yes

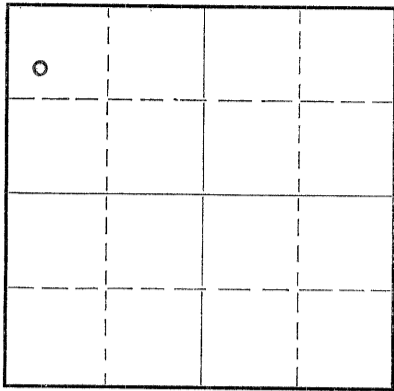

Locate well correctly on above Section Flat

Name of Conservation Agent who supervised plugging of this well Eldon R. Petty  
Producing formation Arbuckle Depth to top 3446 Bottom 3447 Total Depth of Well 3447 Feet  
Show depth and thickness of all water, oil and gas formations.

OIL, GAS OR WATER RECORDS

CASING RECORD

Formation	Content	From	To	Size	Put In	Pulled Out
				8-5/8"	138'	None
				5 1/2"	3436'	1581'

Describe in detail the manner in which the well was plugged, indicating where the mud fluid was placed and the method or methods used in introducing it into the hole. If cement or other plugs were used, state the character of same and depth placed, from.....feet to .....feet for each plug set.

Plugged back with gravel to 3430', Dumped 5 sacks cement on top.  
Filled with heavy mud to 138', pumped 53 sacks cement down surface casing, by Sun Oil Well Cementing Company.

RECEIVED  
Conservation Div.  
MAY 24 1949  
STATE CORPORATION COMMISSION  
KANSAS

(If additional description is necessary, use BACK of this sheet)

Correspondence regarding this well should be addressed to Chas. J. Beu, Box 317  
Address Great Bend, Kansas

STATE OF Kansas, COUNTY OF Barton, ss.  
I, Chas. J. Beu (employee of owner) or (owner or operator) of the above-described well,

being first duly sworn on oath, says: That I have knowledge of the facts, statements, and matters herein contained and the log of the above-described well as filed and that the same are true and correct. So help me God.

(Signature) Chas. Beu

Box 317, Great Bend, Kansas (Address)

SUBSCRIBED AND SWORN to before me this 23rd day of May, 1949

My commission expires March 10, 1953. Eldon M. Jamison Notary Public.

PLUGGING  
FILE SEC 27 & 8 R 19W  
BOOK PAGE 95 LINE 29

H. and H. Drilling Co., Contractor  
 P. O. Box 54  
 Wichita, Kansas

OPERATOR & OWNER  
 Northern Pump Company  
 Box 317  
 Great Bend, Kansas.

Green A. #4  
 SW. NW. NW Sec 27-8-19  
 Rooks County, Kansas

E.L. 1995' D.F.

TOTAL DEPTH: 3445  
 Commenced: 7-21-48  
 Completed: 8-15-48  
 Casing: 8-5/8"---138'---100 Sacks Cement

Figures indicate bottom of formation:

0	to	40	Clay
40		60	Sand
60		138	Shale
138		300	Shale
300		560	Shale
560		640	Dk. Sand
640		945	Shale
945		1430	Shale and Sand
1430		1590	Shale and Shells
1590		1845	Shale
1845		2015	Shale and Shells
2015		2120	Shale and Lime
2120		2255	Lime
2255		2370	Shale
2370		2485	Shale and Shells
2485		2595	Shale
2595		2730	Shale and Lime
2730		2855	Shale and Shells
2855		2990	Shale and Lime
2990		3090	Lime
3090		3135	Lime
3135		3218	Lime
3218		3270	Lime
3270		3305	Lime
3305		3380	Lime K.C.
3380		3409	Lime
3409		3440	Lime
3440		3442 1/2	Lime
3442 1/2		3445	Lime

ROTARY TOTAL DEPTH

Tops --- Elv. 1995' D.F.	
Tepeka	2943
Heebner Shale	3149
Dodge Lime	3172
Lansing-K.C. Lime	3193
Base K.C. Lime & Top	
Marmaton Shale	3405
Arbuckle Dolomite	3436
T.D.	3445

**PLUGGING**  
 FILE NO. 27-8-192  
 WORK PAGE 95 LINE 29

RECEIVED  
 MAY 24 1949