

**WELL PLUGGING RECORD**


OR

**FORMATION PLUGGING RECORD**

Strike out upper line when reporting plugging off formations.

Make Required Affidavit Completely  
 Mail or Deliver Report to:  
 Conservation Division  
 State Corporation Commission  
 870 Bittling Building  
 Wichita, Kansas

Rocks..... County. Sec. **27** Twp. **8** Rge..... (E) **19** (W)  
 Location as "NE $\frac{1}{4}$ NW $\frac{1}{4}$ SW $\frac{1}{4}$ " or footage from lines **SW $\frac{1}{4}$  SW $\frac{1}{4}$  NW $\frac{1}{4}$**   
 Lease Owner **Jones, Shelburne & Farmer, Inc.**  
 Lease Name **Stice** Well No. **1**  
 Office Address **Russell, Kansas**  
 Character of Well (completed as Oil, Gas or Dry Hole) **Dry Hole**  
 Date well completed..... **1-1-48**..... 19.....  
 Application for plugging filed..... **12-30-47**..... 19.....  
 Application for plugging approved..... **12-30-47**..... 19.....  
 Plugging commenced..... **1-1-48**..... 19.....  
 Plugging completed..... **1-1-48**..... 19.....  
 Reason for abandonment of well or producing formation **Dry Hole**

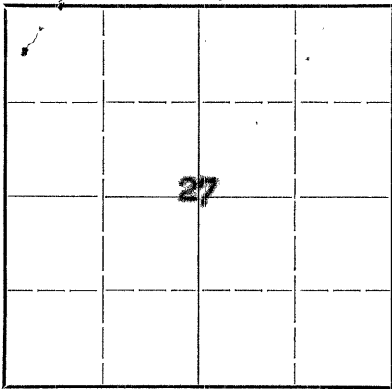

Locate well correctly on above Section Plat

If a producing well is abandoned, date of last production..... **none**..... 19.....  
 Was permission obtained from the Conservation Division or its agents before plugging was commenced?..... **yes**


Name of Conservation Agent who supervised plugging of this well..... **C. D. Stough**  
 Producing formation..... **none**..... Depth to top..... Bottom..... Total Depth of Well **3490** Feet  
 Show depth and thickness of all water, oil and gas formations.

OIL, GAS OR WATER RECORDS CASING RECORD

Formation	Content	From	To	Size	Put In	Pulled Out
<b>none</b>						

Describe in detail the manner in which the well was plugged, indicating where the mud fluid was placed and the method or methods used in introducing it into the hold. If cement or other plugs were used, state the character of same and depth placed, from.....feet to.....feet for each plug set.

**Hole was filled to 270' with heavy mud and plug spotted at this depth. 15 sacks of cement were mixed and placed on top of plug. Hole was filled up to within 30 feet of top and 10 sacks of cement mixed and blance of hole filled with same**

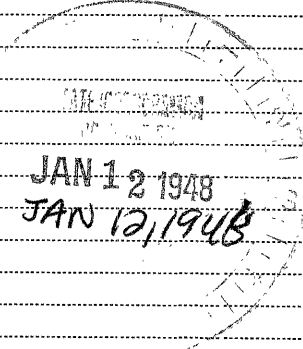

(If additional description is necessary, use BACK of this sheet)

Correspondence regarding this well should be addressed to..... **John O. Farmer**  
 Address..... **Russell, Kansas**

STATE OF Kansas, COUNTY OF Russell, ss.  
John O. Farmer (employee of owner) or (owner or operator) of the above-described well, being first duly sworn on oath, says: That I have knowledge of the facts, statements, and matters herein contained and the log of the above-described well as filed and that the same are true and correct. So help me God.

(Signature) John O. Farmer  
Russell, Kans (Address)

SUBSCRIBED AND SWORN to before me this 8th day of January, 1948  
 My commission expires June 14, 1948  
Leberecht Streckes  
 Notary Public.

**PLUGGING**  
 FILE SEC 27-T-8-R19W  
 BOOK PAGE 7 LINE 25

**CONTRACTOR'S VERIFIED LOG**

Operator Jones, Shelburne & Farmer Farm Name Stice Well No. 1  
 Location SW 1/4 SE 1/4 NW 1/4 Sec. 27-8-19  
 Pool Name Webster County Rooks State Kansas  
 Commencement Date 12-16-47 Completion Date 1-4-48

LOG OF WELL

HBE 8/30/05

Depth		Formation	Deviation from Vertical (Degrees)	Remarks
From	To			
0	8	Surface clay		
8	30	Lime		
30	220	Lime and Shale		
220	920	Shale & Shells		
920	1110	Sand		
1110	1390	Red Rock & Sand		
1390	1430	Anhydrite		
1430	1565	Shale		
1565	1750	Red Rock		
1750	1980	Lime & Shale		
1980	2060	Lime		
2060	2406	Lime & Shale		
2406	2420	Sand		
2420	2553	Lime & Shale		
2553	2605	Lime		
2605	2942	Lime & Shale		
2942	2982	Shale & Lime		
2982	3149	Lime & Shale		
3149	3187	Lime		
3187	3230	Lime & Shale		
3230	3260	Sandy Lime		
3260	3337	Lime & Shale		
3337	3411	Lime & Shale		
3411	3422	Shale		
3422	3490	Lime		

JAN 12, 1948

**PLUGGING**  
 FILE SEC 27 T 8 R 19  
 7 25

