

15-163-02412-00-00


STATE OF KANSAS  
STATE CORPORATION COMMISSION

Give All Information Completely  
Make Required Affidavit  
Mail or Deliver Report to:  
Conservation Division  
State Corporation Commission  
800 Bitting Building  
Wichita, Kansas

WELL PLUGGING RECORD

Rooks County. Sec. 27 Twp. 8 Rge. 19 (E) W (W)

NORTH

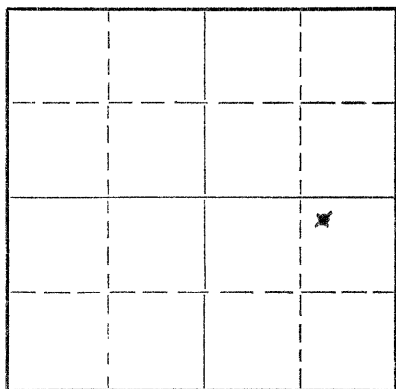

Locate well correctly on above  
Section Plat

Location as "NE/CNW/SW" or footage from lines NW NE SE  
Lease Owner E. K. Carey Contractor  
Lease Name Veverka Well No. 1  
Office Address Box 620, McPherson, Kansas  
Character of Well (completed as Oil, Gas or Dry Hole) Dry Hole  
Date well completed November 29, 19 53  
Application for plugging filed Verbally November 28, 19 53  
Application for plugging approved " 28, 19 53  
Plugging commenced 8 A.M. " 29, 19 53  
Plugging completed 12 Noon " 29, 19 53  
Reason for abandonment of well or producing formation Dry

If a producing well is abandoned, date of last production \_\_\_\_\_ 19\_\_\_\_  
Was permission obtained from the Conservation Division or its agents before plugging was commenced? Yes

Name of Conservation Agent who supervised plugging of this well Eldon Petty, Hays, Kansas  
Producing formation \_\_\_\_\_ Depth to top \_\_\_\_\_ Bottom \_\_\_\_\_ Total Depth of Well 3395 Feet  
Show depth and thickness of all water, oil and gas formations.

OIL, GAS OR WATER RECORDS

CASING RECORD

FORMATION	CONTENT	FROM	TO	SIZE	PUT IN	PULLED OUT
				8-5/8	209'	None

Describe in detail the manner in which the well was plugged, indicating where the mud fluid was placed and the method or methods used in introducing it into the hole. If cement or other plugs were used, state the character of same and depth placed, from 200-115 feet to 40-8 feet for each plug set.

Circulated heavy mud at half way out of hole, ran measuring line with wooden block, filled hole with heavy mud to 200 feet. Made a bridge with tree limbs and top plug from Halliburton, put rock on top of bridge that held drill pipe, cemented with 25 sacks thru drill pipe using Halliburton to mix cement and pump down. Ran measuring line with wooden plug, filled hole with heavy mud to 40', made bridge there using top Halliburton plug with hulls on top plug. Then mix 10 sacks cement thru 1 joint drill pipe, using Halliburton to mix cement and pump down, cemented back to bottom of cellar.

Name of Plugging Contractor E. K. Carey Contractor  
Address Box 620, McPherson, Kansas

STATE OF Kansas, COUNTY OF McPherson, ss.  
Arland Bruce (employee of owner) or (owner or operator) of the above-described well, being first duly sworn on oath, says: That I have knowledge of the facts, statements, and matters herein contained and the log of the above-described well as filed and that the same are true and correct. So help me God.

(Signature) Arland Bruce  
Box 620, McPherson, Kansas  
(Address)

SUBSCRIBED AND SWORN to before me this 30th day of November, 19 53

My commission expires November 13, 1956  
Notary Public.

PLUGGING  
FILE SEC 27 T 8 R 19  
BOOK PAGE 146 LINE 20

Dec 1st, 1953

ROTARY DRILLER'S LOG

E. K. Carey Contractor  
Box 820  
McPherson, Kansas

Elevation: 1939 L. S.

Well No. 1

Casing Record:

No. 28 3/4  
Dec. 27-3-1953  
Books County, Kansas

8-5/8" @ 209' w/136 sks.  
Bulk Cement, 200# cc.

Well Commenced: 11-12-53  
Well Completed: 11-29-53

Contractor: E. K. Carey Contractor, Box 820, McPherson, Kansas  
Geologist: Don Mollar, E. K. Carey Drilg. Co., 915 Central Bldg. Wichita

Figures Indicate Bottom of Formation L. S.

Cellar	8
Clay	30
Shale	190
Lime shells	209
Shale & sand	400
Shale	460
Shale & shells	540
Sand	585
Shale	880
Sand	980
Red Bed	1080
Red Bed	1190
Red Bed & shale	1335
Red Bed	1370
Anhydrite	1395
Shale & lime	1495
Lime & shale	1655
Shale & shells	1800
Shale	1820
Lime & shale	2040
Lime	2205
Lime & shale	2295
Lime	2480
Lime & shale	2580
Lime	2675
Shale & lime	2700
Shale	2815
Shale & lime	2995
Lime & shale	3127
Lime	3206
Lime & shale stks.	3259
Lime	3350
Lime & shale	3378
Arbuckle lime	3387
Lime	3597

Geologist Tops:

Topeka	2685
Hebner	3086 1147
Lansing	3125 1187
Arbuckle	3376 1437
Total Depth	3597

D. S. T. - 3381 used 3' Anchor, packer set 3378, open 30 min., open 20 min. D.H.P. 15%. Recovered 2' mud, very weak blow, dead in 3 minutes.

D. S. T. - 3387 used 9' Anchor at 3378. Tool open 15 min., and 15 min. for D.H.P. 85%. Recovered 5' mud, slight trace of oil.

Above D.S.T. subject to 2' back up the hole correction at completion of hole.

Well D & A @ 3395 November 29, 1953

7  
3086  
1939  
1147

6  
3126  
1939  
1187

6  
3376  
1939  
1437

Correction-Top Arbuckle 3376 = 3374 corrected  
Total Depth - 3597 = 3595 corrected

This is to certify that the above information is to the best of my knowledge true and correct.

SUBSCRIBED AND SWORN to before me this 30th day of November, 1953

E. K. CAREY CONTRACTOR

**PLUGGING** BY Herbert Mott  
FILE SEC 27-T-2-R-190 Herbert Mott, Superintendent  
BOOK PAGE 146 LINE 20

My Commission Expires: November 13, 1958.

Dec 1st, 1953