


Give All Information Completely
Make Required Affidavit
Mail or Deliver Report to:
Conservation Division
State Corporation Commission
800 Bitting Building
Wichita, Kansas

OR
FORMATION PLUGGING RECORD

Strike out upper line
when reporting plug-
ging off formations.

NORTH

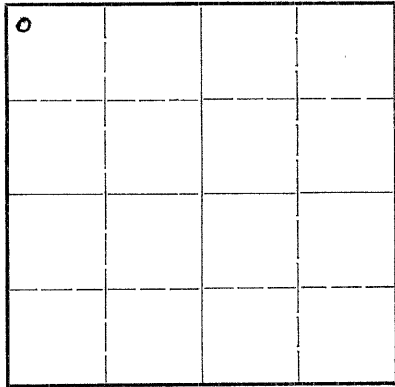

Locate well correctly on above
Section Plat

~~ROOKS~~ ~~XXXXXX~~ County. Sec. 28 Twp. 8 Rge. 19 ~~W~~ (W)
Location as "NE $\frac{1}{4}$ NW $\frac{1}{4}$ SW $\frac{1}{4}$ " or footage from lines. NW NW
Lease Owner P. M. Polhamus
Lease Name Veverka Well No. 1
Office Address Commodore Hotel, Wichita, Kansas
Character of Well (completed as Oil, Gas or Dry Hole) Dry Hole
Date well completed August 26, 19 45
Application for plugging filed August 30, 19 45
Application for plugging approved August 30, 19 45
Plugging commenced August 30, 19 45
Plugging completed September 6, 19 45
Reason for abandonment of well or producing formation Dry Hole

If a producing well is abandoned, date of last production..... 19.....
Was permission obtained from the Conservation Division or its agents before plugging was com-
menced?..... Yes

Name of Conservation Agent who supervised plugging of this well H. W. Kerr, Great Bend, Kansas
Producing formation..... Depth to top..... Bottom..... Total Depth of Well 3493 Feet
Show depth and thickness of all water, oil and gas formations.

OIL, GAS OR WATER RECORDS

CASING RECORD

Formation	Content	From	To	Size	Put In	Pulled Out
				5 $\frac{1}{2}$ "	3481	2844
				8 5/8"	213	0

Describe in detail the manner in which the well was plugged, indicating where the mud fluid was placed and the method or methods used in introducing it into the hold. If cement or other plugs were used, state the character of same and depth placed, from.....feet to.....feet for each plug set.

Run 10 sacks cement at 3275'
Mudded to 200'
Set plug and run 10 sacks cement at 200'
Mudded to 15' to base of cellar
Run 5 sacks cement to cap.

FILED
WICHITA, KANSAS
SEP 1 1945
9/13/45

PLUGGING
FILE 28 8-1945
BOOK PAGE 25 LINE 31

(If additional description is necessary, use BACK of this sheet)

Correspondence regarding this well should be addressed to P. M. Polhamus
Address Commodore Hotel, Wichita, Kansas

STATE OF KANSAS, COUNTY OF SEDGWICK, ss.
P. M. Polhamus ~~XXXXXXXXXXXX~~ (owner or operator) of the above-described well,

being first duly sworn on oath, says: That I have knowledge of the facts, statements, and matters herein contained and the log of the above-described well as filed and that the same are true and correct. So help me God.

(Signature) P. M. Polhamus
Commodore Hotel, Wichita, Kansas
(Address)

SUBSCRIBED AND SWORN to before me this 13th day of September, 1945
M. Helen Anderson
Notary Public.

My commission expires November 5, 1947

Company: P. M. POLHAMUS, ET AL.

SEC. 28 T. 8 R. 19W
NW NW NW

Farm: Veverka No. 1

Total Depth: 3492
Comms: 7-26-45 Comp: 8-26-45
Contractor: Glenn W. Peel Drilling Co.

County: Rocks, Kansas

Production: Dry


CASING: 8-5/8" 213' cemented 100 sacks
5-1/2" 3481' cemented 100 sacks

clay	0-40
sand rock	126
rock & shale	155
shale & shells	580
sand & shale streaks	645
shale & shells	773
sand & shells	796
shale & shells	826
sand & shale	898
sand	920
shale & shells	950
sand	1185
shale	1453
anhydrite	1492
shale & shells	1753
shale & lime streaks	1865
lime	1895
shale & lime	1997
lime & shale streaks	2130
lime	2186
lime & shale	2283
lime	2360
lime & shale	2504
broken lime & shale	2567
lime	2781
shale	2801
lime 2817	2817
broken lime & shale	2875
lime	2909
lime & shale	2975

lime	3043
lime & broken streaks	3097
lime	3466
shale & lime	3487
lime	3493
TOTAL DEPTH	3493

FORMATION TOPS:

Anhydrite	1453'
Heebner	3191'
Lansing	3213'
Arbuckle	3477'

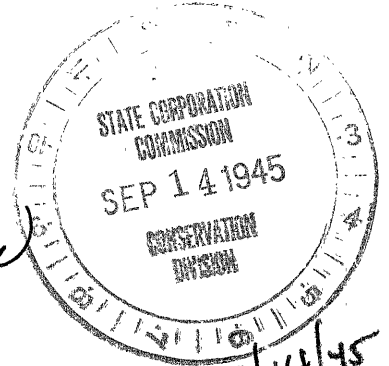

I hereby certify the above log is true and correct to my best knowledge and belief.

P. M. Polhamus
P. M. Polhamus

STATE OF KANSAS }
COUNTY OF SEDGWICK } SS.

On this 8th day of September, A.D. 1945, before me, the undersigned, a Notary Public in and for the County and State aforesaid, personally appeared P. M. POLHAMUS to me known to be the identical person who executed the within and foregoing instrument, and acknowledged to me that he executed the same as his free and voluntary act and deed for the uses and purposes therein set forth.

Given under my hand and seal of office the day and year last above written.

Vivian Gordon
Notary Public

My Commission expires: Sept 25, 1946.