

R 15-163-01143-00-00

WELL PLUGGING RECORD

Give All Information Completely
Make Required Affidavit
Mail or Deliver Report to:
Conservation Division
State Corporation Commission
211 No. Broadway
Wichita, Kansas

Rook's County. Sec. 28 Twp. 8 Rge. 19 (E) (W)

Location as "NE/CNW%SW%" or footage from lines. NE SE

Lease Owner Morgenstern & Specter

Lease Name Veverka Well No. 5

Office Address Russell, Kansas

Character of Well (completed as Oil, Gas or Dry Hole) oil

Date well completed 2-25-47 19

Application for plugging filed February 15, 1962 19

Application for plugging approved February 16, 1962 19


Plugging commenced 2/19/1962 19

Plugging completed 3/2/1962 19

Reason for abandonment of well or producing formation failure to produce profitably

If a producing well is abandoned, date of last production 19

Was permission obtained from the Conservation Division or its agents before plugging was commenced? Yes

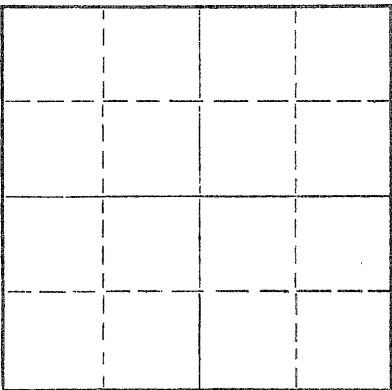

Locate well correctly on above Section Plat

Name of Conservation Agent who supervised plugging of this well Eldon Petty Hays, Kansas

Producing formation Arbuckle Depth to top 3413 Bottom 3418 ft. Total Depth of Well 3419 ft. Feet

Show depth and thickness of all water, oil and gas formations.

OIL, GAS OR WATER RECORDS

CASING RECORD

FORMATION	CONTENT	FROM	TO	SIZE	PUT IN	PULLED OUT
				8 5/8" OD	235 ft.	none
				5 1/2" OD	3417 ft	2727 feet

Describe in detail the manner in which the well was plugged, indicating where the mud fluid was placed and the method or methods used in introducing it into the hole. If cement or other plugs were used, state the character of same and depth placed, from _____ feet to _____ feet for each plug set.

Plugged, back with sand to 3400 feet, Dumped 4-sacks - cement.
Circulated mud at 550 feet. Pumped 20-sacks cement.
Pumped 20-sacks cement at 180 feet.
Set a rock - bridge at 40 - feet, Dumped ten sacks - cement.

RECEIVED
STATE CORPORATION COMMISSION

MAR 19 1962

3/19/62

CONSERVATION DIVISION

(If additional description is necessary, use BACK of this sheet)

Name of Plugging Contractor Lynch Casing Pulling Company No. 457

Address R. Rt. 4 Great Bend, Kansas

STATE OF Kansas, COUNTY OF Russell, ss.
Morgenstern & Specter

(employee of owner) or (owner or operator) of the above-described well, being first duly sworn on oath, says: That I have knowledge of the facts, statements, and matters herein contained and the log of the above-described well as filed and that the same are true and correct. So help me God.

(Signature) [Signature]

(Address) Russell, Kansas

SUBSCRIBED AND SWORN TO before me this 9th day of March, 19 62

My commission expires Dec. 1964

[Signature] Notary Public.



15-163-01143-00-00

WELL LOG BUREAU, KANSAS GEOLOGICAL SOCIETY
412 Union National Bk. Bldg., Wichita, Kansas

Company BIRD & BORING
Farm Veverka No. 5

SEC. 28 T. 8 R. 19W
CE $\frac{1}{2}$ NE SE

Total Depth. 3420' DF
Comm. 4-15-47 Comp. 4-27-47
Shot or Treated.
Contractor. Glenn W. Peel
Issued. 6-21-47

County. Rooks KANSAS



CASING:
8-5/8" 256'
5-1/2" 3428' Cem.

Elevation. _____

Production. Pot. 3058 bbls oil

Figures Indicate Bottom of Formations.

shale	55
sand	65
shale	250
shale & shells	540
sand	850
sand & shale	1145
shale	1175
shale & red bed	1415
anhydrite	1460
shale & shells	1530
shale & lime	1770
shale	1935
shale & lime	2515
shale	2610
lime & shale	3205
lime	3430 DF
Total Depth	

Tops: (DF)	
Lansing	3164
Arbuckle	3428

RECEIVED
STATE CORPORATION COMMISSION
FEB 15 1962
CONSERVATION DIVISION
Wichita, Kansas
2/15/62