

Give All Information Completely
Make Required Affidavit
Mail or Deliver Report to:
Conservation Division
State Corporation Commission
800 Bittling Building
Wichita, Kansas

Rooks County. Sec. 28 Twp. 8S Rge. 19W (E) (W)

Location as "NE/CNW/SW" or footage from lines SE SW NW

Lease Owner K & E Drilling, Inc.

Lease Name Veverka "A" Well No. 2

Office Address 1006 Central Building, Wichita, Kansas

Character of Well (completed as Oil, Gas or Dry Hole) Dry hole

Date well completed October 4 19 53

Application for plugging filed October 4 19 53

Application for plugging approved October 4 19 53

Plugging commenced 4:00 p.m., October 4 19 53


Plugging completed 11:30 p.m., October 4 19 53

Reason for abandonment of well or producing formation

Commercial quantity of oil not found

If a producing well is abandoned, date of last production 19

Was permission obtained from the Conservation Division or its agents before plugging was commenced? Yes

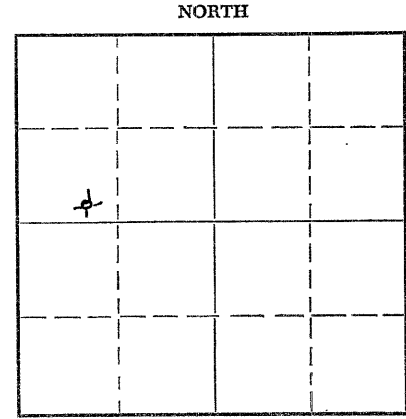

Locate well correctly on above Section Plat

Name of Conservation Agent who supervised plugging of this well Eldon Petty

Producing formation _____ Depth to top _____ Bottom _____ Total Depth of Well 3540 Feet

Show depth and thickness of all water, oil and gas formations.

OIL, GAS OR WATER RECORDS

CASING RECORD

FORMATION	CONTENT	FROM	TO	SIZE	PUT IN	PULLED OUT
				8 5/8	187'	

Describe in detail the manner in which the well was plugged, indicating where the mud fluid was placed and the method or methods used in introducing it into the hole. If cement or other plugs were used, state the character of same and depth placed, from _____ feet to _____ feet for each plug set.

Set plug at 180 feet with 15 sacks cement
Set plug at 30 feet with 10 sacks cement.

10/10/53

(If additional description is necessary, use BACK of this sheet)

Name of Plugging Contractor K & E Drilling, Inc.

Address 1006 Central Building, Wichita, Kansas

STATE OF Kansas, COUNTY OF Sedgwick, ss.

Clinton Engstrand (owner or operator) of the above-described well, being first duly sworn on oath, says: That I have knowledge of the facts, statements, and matters herein contained and the log of the above-described well as filed and that the same are true and correct. So help me God.

(Signature) *Clinton Engstrand*

1006 Central Building, Wichita, Kansas


(Address)

SUBSCRIBED AND SWORN TO before me this 9 day of October, 19 53

Willard Rogers

Notary Public.

My commission expires 10-29-55

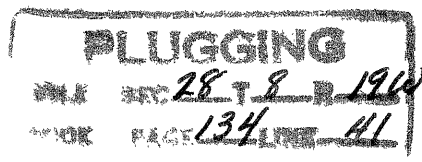

15-163-02517-00-00

K & E DRILLING, INC.
NO. 2 VEVERKA "A"

SE SW NW Sec. 28-8S-19W
ROOKS COUNTY, KANSAS

Casing
8 5/8 " Set @ 187'

Cement
125 Sacks

Comm.: 9-24-53
Comp.: 10-4-53
Total Depth: 3540'

FORMATION

DEPTH

Clay	0 - 30
Sand and Shale	30 - 160
Shale	160 - 187
Shale	187 - 570
Shale and shells	570 - 660
Sand	660 - 695
Shale	695 - 985
Sand	985 - 1230
Sand, Redrock - Red bed and shale w pyrite iron	1230 - 1507
Anhydrite	1507 - 1529
Anhydrite	1529 - 1540
Shale and shells	1540 - 1756
Shale and lime	1756 - 1962
Lime and shale	1962 - 2116
Lime and shale	2116 - 2208
Shale and lime	2208 - 2337
Lime and shale	2337 - 2350
Shale and lime	2350 - 2510
Lime and shale	2510 - 2608
Shale and lime	2608 - 2682
Lime and shale	2682 - 2772
Lime and shale	2772 - 2880
Lime and shale	2880 - 2960
Lime (Kansas City)	2960 - 3243
Lime	3243 - 3250
Lime	3250 - 3286
Lime and shale	3286 - 3422
Lime	3422 - 3440
Arbuckle lime	3440 - 3488
Arbuckle	3488 - 3511
Arbuckle	3511 - 3520
Arbuckle	3520 - 3540

STATE OF KANSAS)
SEDGWICK COUNTY) ss

10/10/53

I hereby certify that the above information is true and correct to the best of my knowledge.

[Signature]

Subscribed and sworn to before me this 9 day of October, 1953.

[Signature]
Notary Public

My Commission Expires: 10-29-55

PLUGGING
FILE SEC 28 T 8 R 19W
PAGE 134 LINE 41