


STATE OF KANSAS
STATE CORPORATION COMMISSION

Give All Information Completely
Make Required Affidavit
Mail or Deliver Report to:
Conservation Division
State Corporation Commission
212 North Market, Insurance Bldg.
Wichita, Kansas

15-163-03182-00-08
WELL PLUGGING RECORD

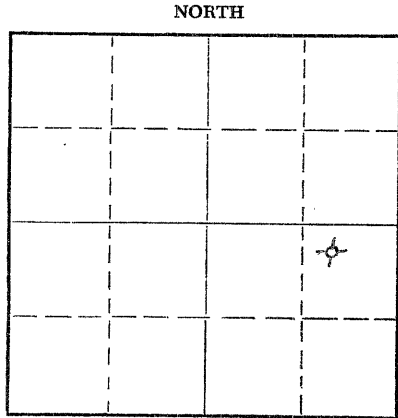

Locate well correctly on above Section Plat

Rooks _____ County. Sec. 28 Twp. 8S Rge. _____ (E) 19 (W)
Location as "NE/CNW/SW" or footage from lines NW NE SE
Lease Owner Peel-Hardman Oil Operators
Lease Name Verveka Well No. 9
Office Address R. R. #3, Box 144B, Wichita 20, Kansas
Character of Well (completed as Oil, Gas or Dry Hole) Oil Well
Date well completed December 18, 19 48
Application for plugging filed June 4, 19 60
Application for plugging approved June 6, 19 60
Plugging commenced June 27, 19 60
Plugging completed July 6, 19 60
Reason for abandonment of well or producing formation No longer a commercial producer.
If a producing well is abandoned, date of last production April 30, 19 60
Was permission obtained from the Conservation Division or its agents before plugging was commenced? Yes

Name of Conservation Agent who supervised plugging of this well Eldon Pitts
Producing formation _____ Depth to top _____ Bottom _____ Total Depth of Well 3485 Feet
Show depth and thickness of all water, oil and gas formations.

OIL, GAS OR WATER RECORDS

CASING RECORD

FORMATION	CONTENT	FROM	TO	SIZE	PUT IN	PULLED OUT
		0	280'	8 5/8"	280'	None
		0	3480'	5 1/2"	3,480'	1967'

Describe in detail the manner in which the well was plugged, indicating where the mud fluid was placed and the method or methods used in introducing it into the hole. If cement or other plugs were used, state the character of same and depth placed, from _____ feet to _____ feet for each plug set.

Top of perforation was at 3440'. Hole was filled with sand from 3480' to 3430'. Five sacks cement placed on bottom of hole with dump bailer. Pipe shot off at 1967' and pulled to 500 feet; Hole was then circulated with mud followed by 20 sacks cement; Pipe then pulled to 180 feet & 20 additional sacks of cement pumped into hole. Balance of pipe pulled and hole filled to bottom of cellar with 10 sacks cement.

JAN 30 1963

CONSERVATION DIVISION
Wichita, Kansas

1/30/63

(If additional description is necessary, use BACK of this sheet)
Name of Plugging Contractor Barnes & Sons pipe Pulling Co.
Address Russell, Kansas

STATE OF KANSAS, COUNTY OF SEDGWICK, ss.
Wm. Herbert (employee of owner) or (~~owner or operator~~) of the above-described well, being first duly sworn on oath, says: That I have knowledge of the facts, statements, and matters herein contained and the log of the above-described well as filed and that the same are true and correct. So help me, God.

(Signature) Wm. Herbert
R. R. #3, Box 144B, Wichita 20, Kansas
(Address)

SUBSCRIBED AND SWORN TO before me this 22 day of January, 19 63

My commission expires March 4, 1966
Marian M. Herbert
Marian M. Herbert Notary Public.



DRILLER'S LOG

Company: W. H. Bird
Glenn W. Peel

Sec. 28 Twp. 8S Rge. 19W
NW NE SW

Farm: Veverka Well No. 9

County: Rooks,
Kansas

Total Depth: 3485' (Rotary)
Comm.: 12-6-48 Comp.: 12-18-48
Contractor: Glenn Weel Drilling Company, Inc.

Elevation:

Production:

Casing:
8 5/8" 280' cem.
5 1/2" 3480' cem.

Figures below indicate bottom of formations

Surface Clay	60
Sand	74
Shale	260
Sand	270
Shale	280
Shale and Shells	540
Sand and Shale	620
Shale	823
Lime	950
Shale and Shells	1150
Shale and Red Bed	1335
Shale	1480
Lime	1505
Shale and Shells	1635
Shale and Lime	1920
Lime and Shale	2470
Lime	2730
Lime and Shale	3085
Lime	3485
Total Depth (Rotary)	3485

RECEIVED
STATE CORPORATION COMMISSION

JAN 30 1963

CONSERVATION DIVISION
Wichita, Kansas

1/30/63

This is to certify that the above information is, to the best of our knowledge, true and correct.

GLENN W. PEEL DRILLING CO., INC.

STATE OF KANSAS
COUNTY OF SEDGWICK

BY: *Marian M. Herbert*
January, 1963

SUBSCRIBED AND SWORN TO before me this 22 day of

My commission expires March 4, 1966

Marian M. Herbert
Marian M. Herbert, Notary Public