


15-163-00749-00-00

WELL PLUGGING RECORD

Give All Information Completely
Make Required Affidavit
Mail or Deliver Report to:
Conservation Division
State Corporation Commission
211 No. Broadway
Wichita, Kansas

Rooks County. Sec. 15 Twp. 10S Rge. 18 (E) ~~W~~(W)
Location as "NE/CNW/SW" or footage from lines NW NW NE
Lease Owner Davis Brothers
Lease Name Flagler Well No. 2
Office Address 14 East 3rd, Tulsa, Oklahoma
Character of Well (completed as Oil, Gas or Dry Hole) D & A
Date well completed May 1, 1958
Application for plugging filed May 1, 1958
Application for plugging approved May 1, 1958
Plugging commenced May 1, 1958
Plugging completed May 1, 1958
Reason for abandonment of well or producing formation No production

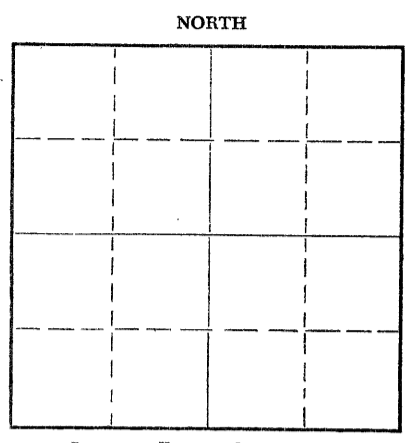

Locate well correctly on above Section Plat

If a producing well is abandoned, date of last production _____ 19____
Was permission obtained from the Conservation Division or its agents before plugging was commenced? Yes

Name of Conservation Agent who supervised plugging of this well Eldon Petty, Box 326, Hays, Kansas
Producing formation _____ Depth to top _____ Bottom _____ Total Depth of Well 3792 Feet
Show depth and thickness of all water, oil and gas formations.

OIL, GAS OR WATER RECORDS

CASING RECORD

FORMATION	CONTENT	FROM	TO	SIZE	PUT IN	PULLED OUT
				8 5/8"	177	None

Describe in detail the manner in which the well was plugged, indicating where the mud fluid was placed and the method or methods used in introducing it into the hole. If cement or other plugs were used, state the character of same and depth placed, from _____ feet to _____ feet for each plug set.

Filled hole with heavy drilling mud to 500', set plug, cemented with 20 sacks of cement.

Filled hole with heavy drilling mud to 160', set plug, cemented with 1/2 sack of hulls and 15 sacks of cement.

Filled hole with heavy drilling mud to 40', set plug, cemented with 1/2 sack of hulls and 10 sacks of cement to bottom of cellar.

(If additional description is necessary, use BACK of this sheet)

Name of Plugging Contractor Transit Corporation
Address 1516 Liberty Bank Building, Oklahoma City, Oklahoma

STATE OF Oklahoma, COUNTY OF Oklahoma, ss.
L. J. Kruse (employee of owner) or (owner or operator) of the above-described well, being first duly sworn on oath, says: That I have knowledge of the facts, statements, and matters herein contained and the log of the above-described well as filed and that the same are true and correct. So help me God.

(Signature) L. J. Kruse
1516 Liberty Bank Bldg. (Address)

SUBSCRIBED AND SWORN TO before me this 12 day of May 1958
R. E. S. Scheck Notary Public.

My commission expires Oct. 13 - 1961

05-16-1958

PLUGGING
FILE SEC. 15 T. 10 R. 18W
BOOK PAGE 98 LINE 32

15-163-00749-00-00

DRILLER'S WELL LOG

CS-8-29-07

Davis Brothers- Flagler # 2 located in NW NW ~~SE~~^{NE} Sec. 15-
10S-18W, Rooks County, Kansas

Commenced: April 17, 1958
Completed: May 1, 1958
Elevation: 2181 KB

Casing 8 5/8" @ 174
Cemented 130 sacks

<u>Formation</u>	<u>From</u>	<u>To</u>
Clay, sand and blue shale	0	174
Shale	174	630
Sand	630	810
Shale	810	1263
Shale and shells	1263	1550
Anhydrite	1550	1585
Shale and shells	1585	2045
Lime and shale	2045	3422
Lime	3422	3520
Lime (Chert)	3520	3559
Lime	3559	3665
Conglomerate	3665	3730
Cherty conglomerate	3730	3735
Shale and sand	3735	3751
Dolomite and shale	3751	3772
Lime	3772	3774
Arbuckle	3774	3792 TD

Summary of Formation

Topeka	3152'
Heebner	3370'
Toronto	3390'
Kansas City	3414'
Conglomerate	3668'
Ero Simpson	3711'
Simpson	3731'
Arbuckle	3772'

I hereby certify the foregoing to be a true and accurate Driller's Log of the formation encountered in the above well.

TRANSIT CORPORATION

By L. J. Kruse

Subscribed and sworn to before me
this 13th day of May, 1958.

My Commission expires Oct. 13, 1961

R. S. Sibley
Notary Public

PLUMBER
FILE SEC. 15 10 18W
BOOK PAGE 98 LINE 32