


STATE OF KANSAS  
STATE CORPORATION COMMISSION

15-163-02565-00-00  
WELL PLUGGING RECORD

Give All Information Completely  
Make Required Affidavit  
Mail or Deliver Report to:  
Conservation Division  
State Corporation Commission  
800 Biting Building  
Wichita, Kansas

NORTH

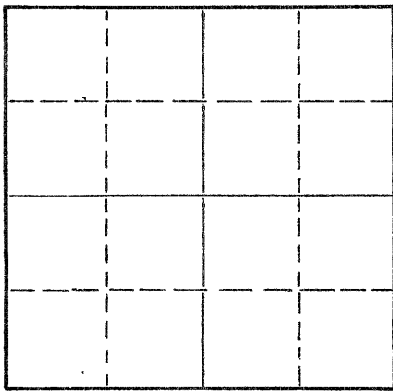

Locate well correctly on above  
Section Plat

Rooks County, Sec. 15 Twp. 10 Rge. 18 (W)

Location as "NE/CNW/SW" or footage from lines SE SE NW  
Lease Owner Lee Phillips, Jr.  
Lease Name Dahna Well No. 1  
Office Address 1407 Union Nat'l Bank Bldg., Wichita, Kansas  
Character of Well (completed as Oil, Gas or Dry Hole) Dry Hole  
Date well completed June 8, 1955 19  
Application for plugging filed June 8, 1955 19  
Application for plugging approved June 8, 1955 19  
Plugging commenced June 8, 1955 19  
Plugging completed June 8, 1955 19  
Reason for abandonment of well or producing formation Dry Hole

If a producing well is abandoned, date of last production 19  
Was permission obtained from the Conservation Division or its agents before plugging was commenced? Yes

Name of Conservation Agent who supervised plugging of this well Eldon Petty  
Producing formation \_\_\_\_\_ Depth to top \_\_\_\_\_ Bottom \_\_\_\_\_ Total Depth of Well 3720 Feet  
Show depth and thickness of all water, oil and gas formations.

OIL, GAS OR WATER RECORDS

CASING RECORD

FORMATION	CONTENT	FROM	TO	SIZE	PUT IN	PULLED OUT
	Surface Pipe	0	1480'	8-5/8"	1480'	None

Describe in detail the manner in which the well was plugged, indicating where the mud fluid was placed and the method or methods used in introducing it into the hole. If cement or other plugs were used, state the character of same and depth placed, from \_\_\_\_\_ feet to \_\_\_\_\_ feet for each plug set.

Filled hole with heavy mud to 210'.  
Bridged hole at 210'. Ran 20 sacks  
cement 210' up. Bridge hole at 40',  
ran 10 sacks cement, plug 40' to  
base of cellar.

(If additional description is necessary, use BACK of this sheet)

Name of Plugging Contractor Isern Drilling Company  
Address Ellinwood, Kansas

STATE OF KANSAS, COUNTY OF BARTON, ss.  
I, M. M. Shropshire (employee of owner/owner/operator) of the above-described well, being first duly sworn on oath, says: That I have knowledge of the facts, statements, and matters herein contained and the log of the above-described well as filed and that the same are true and correct. So help me God.

(Signature) M. M. Shropshire  
Lyons, Kansas (Address)

SUBSCRIBED AND SWORN TO before me this 9th day of June, 1955

George A. Meyer  
Notary Public.

My commission expires Feb. 10, 1959

RECEIVED  
STATE CORPORATION COMMISSION

PLUGGING  
FILE SEC 15 T10 R18W  
BOOK PAGE 126 LINE 22

06-14-1955

15-163-02565-00-00

WELL LOG

LEE PHILLIPS, JR., Owner - Dahna #1  
SE/4 SE/4 NW/4 Section 15, Township 10, Range 18W,  
Rooks County, Kansas

ELEVATION: 2118 DF

Figures indicate bottom of formation

0	to	20	sand
		50	lime & shale
		685	shale & shells
		760	sand
		970	shale & shells
		1155	sand
		1476	shale & shells
		1510	Anhydrite
		1830	shale & shells
		1950	salt
		2150	shale & shells
		2400	lime & shale
		2575	shale & shells
		2685	lime & shale
		3100	shale & shells
		3305	lime & shale
		3309	Heebner
		3598	lime & shale
		3681	Conglomerate
		3706	Simpson
		3720	Arbuckle
		3720	Total Depth D&A

PIPE RECORD:

8-5/8" set at 1480'  
Cemented with 750 sacks.

TOPS: RBM

Heebner	3305
Kansas City	3348
Conglomerate	3598
Simpson	3681
Arbuckle	3706

Rotary Commenced	5-30-55
Completed	6-8-55

STATE OF KANSAS )  
COUNTY OF BARTON ) SS

I, M. M. Shropshire, Drilling Superintendent of the above-described well, being first duly sworn on oath, declare: That I have knowledge of the facts, statements and matters herein contained pertaining to the log of the above-described well, as filed, and that the same are true and correct.

M. M. Shropshire

Subscribed and Sworn to before me this 9th day of June, 1955.

George A Meyer

Notary Public

My commission expires Feb. 10, 1959.

**PLUGGING**  
FILE SEC 15 T 10 R 18W  
BOOK PAGE 126 LINE 22