

CARD MUST BE TYPED

State of Kansas
NOTICE OF INTENTION TO DRILL
(see rules on reverse side)

CARD MUST BE SIGNED

Starting Date: ... April 20 85
month day year

API Number 15-163-01,016-00-01

OPERATOR: License # ... K-5537

40⁰. S. SW. NE NE Sec. 29. Twp. 10 S, Rge. 18. East
(location) West

Name ... Kenny Brown Enterprises

Address ... Drawer 340

..4250..... Ft North from Southeast Corner of Section

City/State/Zip ... Plainville, Kansas 67663

..990..... Ft West from Southeast Corner of Section

Contact Person ... Kenneth O. Brown

(Note: Locate well on Section Plat on reverse side)

Phone ... 913-434-7236

Nearest lease or unit boundary line 990 feet.

CONTRACTOR: License # 9087

County Rooks

Name .. R. * G. Drilling Company

Lease Name ... Dauwe Well# 4

City/State ... Hays, Kansas

Domestic well within 330 feet : yes no

Well Drilled For: Well Class: Type Equipment:

Municipal well within one mile : yes no

Oil Swd Infield Mud Rotary

Depth to Bottom of fresh water 160 feet

Gas Inj Pool Ext. Air Rotary

Lowest usable water formation Dakota

OWWO Expl Wildcat Cable

Depth to Bottom of usable water see 260 feet

If OWWO: old well info as follows:

Surface pipe by Alternate : 1 2

Operator ... Davis Bros

Surface pipe ~~set~~ set 168 feet

Well Name ... Buell "A" # 1

Conductor pipe if any required feet

Comp Date 12-15-61.. Old Total Depth 3689'

Ground surface elevation 2079 feet MSL

Projected Total Depth 3668 feet

This Authorization Expires 10-5-85

Projected Formation at TD ... Arbuckle

Approved By R.C.H./K.C.C. 4-5-85

Expected Producing Formations ... LKO

I certify that we will comply with K.S.A. 55-101, et seq., plus eventually plugging hole to K.C.C. specifications.

Date 4-7-85 Signature of Operator or Agent Kenneth O. Brown Title owner & operator

Form C-1 4/84

KON-KDHE 4-5-85


1030 from North bit
990 " Earl bit

Must be filed with the K.C.C. five (5) days prior to commencing well
This card void if drilling not started within six (6) months of date received by K.C.C.

RECEIVED
STATE CORPORATION COMMISSION
04-05-1985
APR 5 1985

Important procedures to follow :

A Regular Section of Land
1 Mile ⁵²⁸⁰ ₃₃₀ Ft

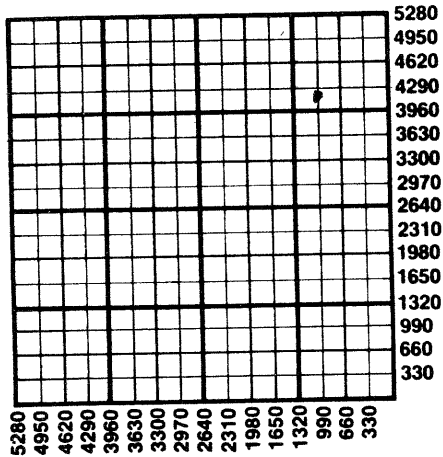

1. Notify District office before setting surface casing.
2. Set surface casing by circulating cement to the top.
3. File completion forms ACO-1 with K.C.C. within 90 days of well completion, following instructions on ACO-1, side 1, and including copies of wireline logs.
4. Notify District office 48 hours prior to old well workover or re-entry.
5. Prior to plugging, prepare a plugging plan, then obtain agreement from the appropriate district office for an approved plugging plan.
6. Submit plugging report (CP-4) to K.C.C. after plugging is completed.
7. Obtain an approved injection docket number before disposing of salt water.
8. Notify K.C.C. within 10 days when injection commences or terminates.
9. If an alternate 2 completion, cement in the production pipe from below any usable water to surface within 120 days of spud date.

State Corporation Commission of Kansas
Conservation Division
200 Colorado Derby Building
Wichita, Kansas 67202
(316) 263-3238