


15-163-00384-00-00

WELL PLUGGING RECORD

Give All Information Completely
Make Required Affidavit
Mail or Deliver Report to:
Conservation Division
State Corporation Commission
800 Biting Building
Wichita, Kansas

NORTH

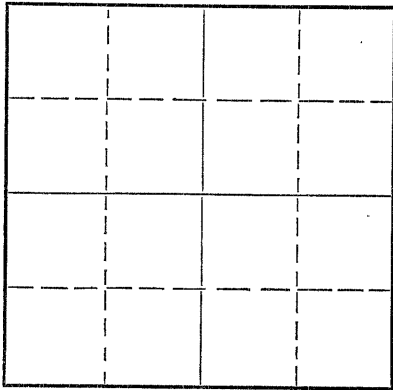

Locate well correctly on above
Section Plat

Rooks _____ County. Sec. 25 Twp. 10 Rge. (E) 18 (W)
Location as "NE/CNW $\frac{1}{4}$ SW $\frac{1}{4}$ " or footage from lines SE SE SE
Lease Owner Graham-Messman-Rinehart Oil Company
Lease Name Wiesner Well No. 1
Office Address 204 North Market, Wichita, Kansas
Character of Well (completed as Oil, Gas or Dry Hole) Dry
Date well completed October 25, 1951
Application for plugging filed November 2
Application for plugging approved October 26
Plugging commenced October 26
Plugging completed October 27
Reason for abandonment of well or producing formation Dry

If a producing well is abandoned, date of last production _____ 19____
Was permission obtained from the Conservation Division or its agents before plugging was commenced? Yes

Name of Conservation Agent who supervised plugging of this well Eldon Petty
Producing formation _____ Depth to top _____ Bottom _____ Total Depth of Well 3690 Feet
Show depth and thickness of all water, oil and gas formations.

OIL, GAS OR WATER RECORDS

CASING RECORD

Formation	Content	From	To	Size	Put In	Pulled Out
				8 5/8"	226'	None

Describe in detail the manner in which the well was plugged, indicating where the mud fluid was placed and the method or methods used in introducing it into the hole. If cement or other plugs were used, state the character of same and depth placed, from _____ feet to _____ feet for each plug set.

Plugged hole at 200' with 15 sx cement
Top plug at 35', cement to top of surface
pipe, 40' - Halliburton plug at 40';
1/2 sack hulls w/10 sx cement to 3'.
Mud to surface.

RECEIVED
STATE OF KANSAS
11-24-1951
NOV 24 1951


(If additional description is necessary, use BACK of this sheet)
Name of Plugging Contractor Graham-Messman-Rinehart Oil Company, Wichita, Kansas
Address 204 North Market

STATE OF Kansas, COUNTY OF Sedgwick, ss.
J. A. Gilliland (employee of owner) or (owner or operator) of the above-described well,
being first duly sworn on oath, says: That I have knowledge of the facts, statements, and matters herein contained and the log of the above-described well as filed and that the same are true and correct. So help me God.

(Signature) J. A. Gilliland
204 North Market, Wichita, Kansas
(Address)

SUBSCRIBED AND SWORN TO before me this 23rd day of November 19 51

My commission expires March 21, 1955 Oliver Carter Notary Public.

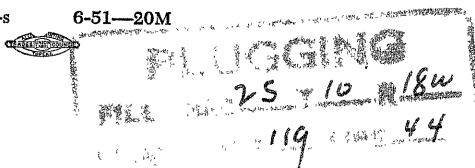

COPY

15-163-00384-00-00

WELL LOG

Graham-Messman-Rinehart Oil Co.

Described as your Wiesner Well #1, located SE SE SE Sec. 25-10S-18W, Rooks Co., Kansas.

FROM	TO	FORMATION
0	160	Sand & shale
160	227	Shale
227	700	Shale
700	850	Shale & shells
850	1020	Sand
1020	1190	Red Bed & shale
1190	1240	Red Bed & Shale
1240	1280	Sand & shale
1280	1400	Shale & lime
1400	1720	Shale & shells
1720	1895	Shale & shells
1895	1950	Lime
1950	2100	Shale & lime
2100	2215	Broken lime
2215	2315	Lime & shale streaks
2315	2390	Shale & lime
2390	2444	Lime
2444	2535	Shale and lime streaks
2535	2650	Lime & shale
2650	2730	Broken lime
2730	2798	Lime
2798	2857	Lime & shale
2857	2965	Shale
2965	3035	Shale & lime streaks
3035	3060	Lime & shale
3060	3106	Lime & shale
3106	3148	Shale
3148	3173	Lime
3173	3242	Lime & shale
3242	3283	Lime & shale
3283	3321	Lime
3321	3363	Lime & shale
3363	3423	Lime
3423	3469	Lime & shale
3469	3497	Lime
3497	3525	Lime
3525	3625	Lime
3625	3643	Lime & shale
3643	3653	Cong.
3653	3665	Arb.
3665	3690	Arb. lime
3690		Total Depth

I, the undersigned, being first duly sworn upon oath, state that this well record is true, correct and complete according to the records of this office and to the best of my knowledge and belief,

S/ D. Given
D. Given

Subscribed and sworn to before me this 5th day of November, 1951.

(Seal)

11-24-1951

My Commission Expires:
October 14, 1953.

PLUGGING
FILE 25 10 18w
119 44

S/ Art M. Trump
Notary Public