

STATE OF KANSAS
STATE CORPORATION COMMISSION


15-163-04207-00-00
WELL PLUGGING RECORD

Give All Information Completely
Make Required Affidavit
Mail or Deliver Report to:
Conservation Division
State Corporation Commission
800 Bitting Building
Wichita, Kansas

OR
FORMATION PLUGGING RECORD

Strike out upper line
when reporting plug-
ging off formations.

NORTH

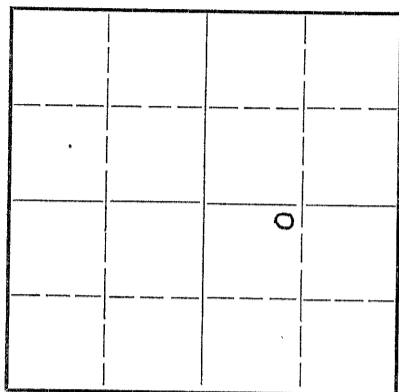

Locate well correctly on above
Section Plat

Rooks County, Sec. 25 Twp. 10S Rge. 18W (E) (W)

Location as "NE $\frac{1}{4}$ NW $\frac{1}{4}$ SW $\frac{1}{4}$ " or footage from lines NE $\frac{1}{2}$ NW $\frac{1}{2}$ SE $\frac{1}{2}$

Lease Owner Continental Oil Co.

Lease Name Peoples Trust Co.

Well No. ANW KCC

Office Address Ponca City, Oklahoma

Character of Well (completed as Oil, Gas or Dry Hole) Stratigraphic Test

Date well completed March 29, 1943

Application for plugging filed March 29, 1943

Application for plugging approved March 29, 1943

Plugging commenced March 29, 1943

Plugging completed March 30, 1943

Reason for abandonment of well or producing formation Stratigraphic Test

If a producing well is abandoned, date of last production 19

Was permission obtained from the Conservation Division or its agents before plugging was commenced? Yes

Name of Conservation Agent who supervised plugging of this well C. T. Alexander

Producing formation Depth to top Bottom Total Depth of Well 3650 Feet

Show depth and thickness of all water, oil and gas formations.


OIL, GAS OR WATER RECORDS

CASING RECORD

Formation	Content	From	To	Size	Put In	Pulled Out
				8 5/8"	104 ft.	none

Describe in detail the manner in which the well was plugged, indicating where the mud fluid was placed and the method or methods used in introducing it into the hold. If cement or other plugs were used, state the character of same and depth placed, from feet to feet for each plug set.

The hole was filled with heavy mud by circulating every 500 feet. A plug was set at 112 ft. and 15 sacks of cement put on it through the drill pipe. The hole was then filled to 20 feet where another plug was set and 5 sacks of cement placed on top.

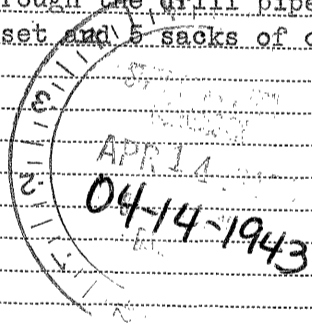

25 10 18W
68 42

(If additional description is necessary, use BACK of this sheet)

Correspondence regarding this well should be addressed to J. George Klein

Address Box 6 Plainville, Kansas

STATE OF Kansas COUNTY OF Rooks ss.
J. George Klein (employee of owner) or (owner or operator) of the above-described well,

being first duly sworn on oath, says: That I have knowledge of the facts, statements, and matters herein contained and the log of the above-described well as filed and that the same are true and correct. So help me God

(Signature) J. George Klein
Plainville, Kansas (Address)

SUBSCRIBED AND SWORN to before me this 13th day of April, 1943

My commission expires March 6, 1944

Georgia Reed
Notary Public.

