

STATE OF KANSAS
STATE CORPORATION COMMISSION


15-163-02397-00-00
WELL PLUGGING RECORD

OR
FORMATION PLUGGING RECORD

Strike out upper line
when reporting plug-
ging of formations.

Give All Information Completely
Make Required Affidavit
Mail or Deliver Report to:
Conservation Division
State Corporation Commission
800 Bitting Building
Wichita, Kansas

Rocks County. Sec. 25 Twp. 10 Rge. 18 (B) W (X)
Location as "NE $\frac{1}{4}$ NW $\frac{1}{4}$ SW $\frac{1}{4}$ " or footage from lines. SW SW SW
Lease Owner Bridgeport Oil Company, Inc. and H. B. Peatling
Lease Name Peatling "A" Well No. 1
Office Address 914 Central Building - Wichita 2, Kansas
Character of Well (completed as Oil, Gas or Dry Hole) Dry Hole
Date well completed 10 - 19 1947
Application for plugging filed 10 - 24 1947
Application for plugging approved 10 - 18 1947
Plugging commenced 10 - 18 1947
Plugging completed 10 - 19 1947
Reason for abandonment of well or producing formation Dry Hole

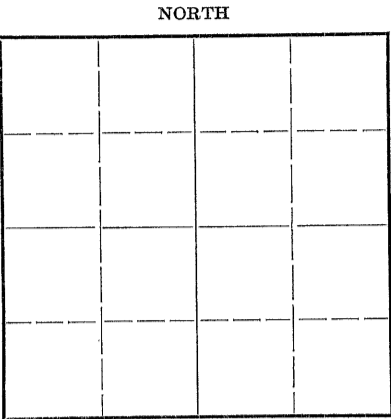

Locate well correctly on above
Section Plat

If a producing well is abandoned, date of last production 19.....
Was permission obtained from the Conservation Division or its agents before plugging was com-
menced? Yes

Name of Conservation Agent who supervised plugging of this well Mr. Stough - Hays, Kansas
Producing formation Depth to top Bottom Total Depth of Well 3705 Feet
Show depth and thickness of all water, oil and gas formations.

OIL, GAS OR WATER RECORDS

CASING RECORD

Formation	Content	From	To	Size	Put In	Pulled Out
Surface	water	0	155	8 5/8	155'	none

Describe in detail the manner in which the well was plugged, indicating where the mud fluid was placed and the method or methods used in introducing it into the hold. If cement or other plugs were used, state the character of same and depth placed, from feet to feet for each plug set.

Filled with heavy mud to 155'
Wooden bridge at 155'
15 sacks cement to 115'
Heavy mud to 30'
Wooden bridge and 15 sacks cement 30' to bottom of cellar

(If additional description is necessary, use BACK of this sheet)

Correspondence regarding this well should be addressed to Bridgeport Oil Company, Inc.
Address 914 Central Building - Wichita 2, Kansas


STATE OF Kansas, COUNTY OF Sedgwick, ss.
Frank Leach (employee of owner) or (owner or operator) of the above-described well,
being first duly sworn on oath, says: That I have knowledge of the facts, statements, and matters herein contained and the log of the above-described well as filed and that the same are true and correct. So help me God.

(Signature) Frank Leach
Wichita, Kansas

SUBSCRIBED AND SWORN to before me this 24th day of October

10-25 1947
Masha Lepp
Notary Public.

My commission expires April 13, 1949

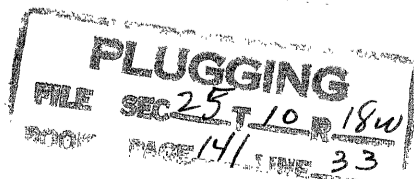

15-163-02397-00-00

BRIDGEMONT OIL COMPANY, INC.
914 Central Building
Wichita 2, Kansas

Well Log Drilling #1 No. 1
NW 34 SW 25-103-18W
Rooks County, Kansas

Elevation 2049'
Date Commenced 10-2-47
Date Completed 10-19-47

Casing Record:
6-2/8" casing cemented 3
150' with 100 gauge cement.

Rotary tools 0' to 3705' T.D.

LOG		
0	710	Shale and Shells
710	750	Sand and Shells
750	805	Shale and Shells
805	995	Sandy Shale
995	1050	Lime
1050	1060	Shale and Lime
1060	1115	Sandy Shale
1115	1300	Shale and Shells
1300	1412	Anhydrite
1412	1905	Shale and Shells
1905	1950	Broken Lime and Shale
1950	2070	Shale and Lime shells
2070	2205	Shale and Shells
2205	2250	Lime
2250	2325	Fr. Riley
2325	2380	Lime
2380	2445	Shale and Shells
2445	2570	Shale and Lime
2570	2610	Lime
2610	2705	Shale and Lime
2705	2712	Shale and Shells
2712	2740	Lime and Shale
2740	2865	Shale and Lime
2865	2915	Lime
2915	3085	Lime and Shale
3085	3135	Lime
3135	3257	Conglomerate
3257	3707	Lime
3707	3705	Derrick Floor

FINISHING LOG	
Top Reelbar	3135
Top Landing	3257
Top Conglomerate	3257
Top Anhydrite	3412

I, Frank Leach, do hereby certify that the above log is correct to the best of my knowledge and belief.

BRIDGEMONT OIL COMPANY, INC.

BY Frank Leach

PLUGGING
FILE SEC 25 T 10 R 18W
BOOK PAGE 141 LINE 33

10-25-1947