

15-163-20386-00-00

STATE OF KANSAS
STATE CORPORATION COMMISSION

Form CP-4

Give All Information Completely
Make Required Affidavit
Mail or Deliver Report to:
Conservation Division
State Corporation Commission
212 No. Market
Wichita, Kansas 67202


WELL PLUGGING RECORD

ROOKS County. Sec. 33 Twp. 10s Rge. 18 (E) (W)
Location as "NE/CNW/SW" or footage from lines App. NE SE NW
Lease Owner PETROLEUM, INC.
Lease Name VINE 'C' Well No. 1
Office Address R.R. #2, GREAT BEND, KANSAS
Character of Well (completed as Oil, Gas or Dry Hole) DRY HOLE
Date well completed AUGUST 17 1971
Application for plugging filed AUGUST 17 19 71
Application for plugging approved AUGUST 17 19 71
Plugging commenced AUGUST 17 19 71
Plugging completed AUGUST 17 19 71
Reason for abandonment of well or producing formation NO COMMERCIAL ZONE

If a producing well is abandoned, date of last production NONE 19
Was permission obtained from the Conservation Division or its agents before plugging was commenced? YES

Name of Conservation Agent who supervised plugging of this well LEO F. MASSEY
Producing formation _____ Depth to top _____ Bottom _____ Total Depth of Well 3660 Feet

Show depth and thickness of all water, oil and gas formations.

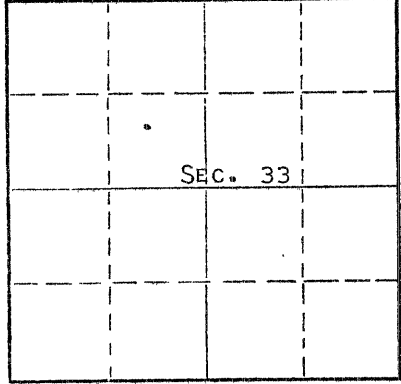

Locate well correctly on above Section Plat

OIL, GAS OR WATER RECORDS

CASING RECORD

FORMATION	CONTENT	FROM	TO	SIZE	PUT IN	PULLED OUT
				8-5/8"	216'	NONE

Describe in detail the manner in which the well was plugged, indicating where the mud fluid was placed and the method or methods used in introducing it into the hole. If cement or other plugs were used, state the character of same and depth placed, from _____ feet to _____ feet for each plug set.

HEAVY MUD TO 550', WOODEN PLUG, PLACED 70 SACKS CEMENT ON TOP OF PLUG,
HEAVY MUD TO 210', WOODEN PLUG, PLACED 20 SACKS CEMENT ON TOP OF PLUG,
HEAVY MUD TO 40', 1/2 SACK HULLS, WOODEN PLUG, PLACED 10 SACKS CEMENT ON
TOP OF PLUG TO BASE OF WELL CELLAR

RECEIVED
STATE CORPORATION COMMISSION
AUG 23 1971
CONSERVATION DIVISION
Wichita, Kansas

08-23-1971

(If additional description is necessary, use BACK of this sheet)

Name of Plugging Contractor GARVEY DRILLING CO.
Address R.R. #2, GREAT BEND, KANSAS

STATE OF KANSAS, COUNTY OF BARTON, ss.

LAWRENCE PROFFITT (employee of owner) or (owner or operator) of the above-described well, being first duly sworn on oath, says: That I have knowledge of the facts, statements, and matters herein contained and the log of the above-described well as filed and that the same are true and correct. So help me God. LAWRENCE PROFFITT, DIST. PROD. FOREMAN

(Signature) _____
R.R. #2, GREAT BEND, KANSAS
(Address)

20 day of AUGUST, 19 71

Notary Public.



My commission expires APRIL 14, 1975

WELL LOG

15-163-20386-00-00

COMPANY Petroleum, Inc.

BEC. 33 T.10S R.18W

FARM Vine "C"

NO. 1

LOC. NE SE NW


TOTAL DEPTH 3660'

COUNTY Rooks, Kansas

COMM. 8-7-71.

COMP. 8-17-71.

CONTRACTOR Garvey Drilling Company

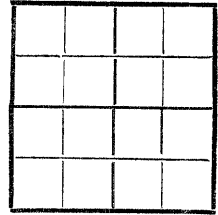

CASING

8 5/8" @ 216' w/175sx

ELEVATION 2034' KB

PRODUCTION D & A

FIGURES INDICATE BOTTOM OF FORMATIONS

- 50' Post Rock
- 216' Shale
- 750' Shale & Sand
- 1386' Shale
- 1430' Anhydrite
- 1575' Shale
- 2290' Shale w/Lime
- 3275' Lime & Shale
- 3320' Lime
- 3660' Lime
- 3660' RTD

RECEIVED
 AUG 23 1971
 STATE CORPORATION COMMISSION
 WICHITA, KANSAS

08-23-1971

State of Kansas }
 County of Barton } SS

I, Charlene Marker of Garvey Drilling Company

upon oath state the above and foregoing to be true and correct copy of the log of the Vine "C" #1 well.



Subscribed and sworn to before this 18th day of August 1971.

My Commission Expires: July 8, 1974

Charlene Marker
Gene C. Morris
 NOTARY PUBLIC