

STATE OF KANSAS  
STATE CORPORATION COMMISSION


15-163-21690-00-00

WELL PLUGGING RECORD

Give All Information Completely  
Make Required Affidavit  
Mail or Deliver Report to  
Conservation Division  
State Corporation Comm.  
245 North Water  
Wichita, KS 67202

Rooks County, Sec. 32 Twp. 10S Rge. 18 NE/W  
Location as "NE/CNW $\frac{1}{4}$ SW $\frac{1}{4}$ " or footage from lines

NE SW SW  
Lease Owner Rains & Williamson Oil Co., Inc.  
Lease Name Peavey Well No. #1  
Office Address 435 Page Court, 220 W. Douglas, Wichita, Ks.  
Character of Well (Completed as Oil, Gas or Dry Hole)

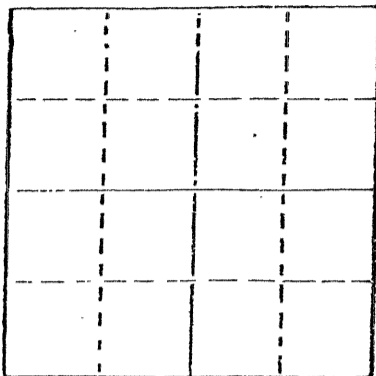

Locate well correctly on above Section Plat

Dry Hole  
Date Well completed 5-30-82 19  
Application for plugging filed 5-30-82 19  
Application for plugging approved 5-30-82 19  
Plugging commenced 5-30-82 19  
Plugging completed 5-30-82 19

Reason for abandonment of well or producing formation  
Commercial quantities of oil not found  
If a producing well is abandoned, date of last production 19

Was permission obtained from the Conservation Division or its agents before plugging was commenced? Yes

Name of Conservation Agent who supervised plugging of this well Dennis Hamel  
Producing formation \_\_\_\_\_ Depth to top \_\_\_\_\_ Bottom \_\_\_\_\_ Total Depth of Well 3600'  
Show depth and thickness of all water, oil and gas formations.

OIL, GAS OR WATER RECORDS

CASING RECORD

FORMATION	CONTENT	FROM	TO	SIZE	PUT IN	PULLED OUT
				8 5/8"	362'	None

Describe in detail the manner in which the well was plugged, indicating where the mud fluid was placed and the method or methods used in introducing it into the hold. If cement or other plugs were used, state the character of same and depth placed, from \_\_\_\_\_ feet to \_\_\_\_\_ feet for each plug set.

Plug @ 1400' w/20 sx.  
Plug @ 750' w/50 sx.  
Plug @ 230' w/40 sx.  
Plug @ 40' w/10 sx.  
Rat Hole 10 sx.

*Rec'd  
06-11-1982*

(If additional description is necessary, use BACK of this sheet)

Name of Plugging Contractor Rains & Williamson Oil Co., Inc.

STATE OF Kansas COUNTY OF Sedgwick, ss.  
Wilson Rains, President of Rains & Williamson Oil Co. (employee of owner) or (owner or operator) of the above-described well, being first duly sworn on oath, says: That I have knowledge of the facts, statements, and matters herein contained and the log of the above-described well as filed and that the same are true and correct. So help me God.

(Signature) Wilson Rains  
435 Page Court, 220 W. Douglas, Wichita, Ks. 67202  
(Address)

SUBSCRIBED AND SWORN TO before me this 9 day of June, 19 82



Juanita M. Green  
Juanita M. Green Notary Public.

15-163-21690-00

DRILLER'S LOG

COMPANY: Rains & Williamson Oil Co., Inc.

SEC. 32 T. 10S R. 18W

WELL NAME: Peavey #1

LOC. NE SW SW

COUNTY: Rooks

RIG NO. #11

TOTAL DEPTH 3600'

ELEVATION 1990 GL 1997 KB

COMMENCED: 5-22-82

COMPLETED: 5-30-82

CONTRACTOR: Rains & Williamson Oil Co., Inc.

CASING RECORD:

SURFACE: 8 5/8" @ 362' w/225 sx. common, 3% cc., 2% gel.

PRODUCTION: D&A

LOG

(Figures Indicate Bottom of Formations)

Sand & Shale	240
Shale	2180
Shale & Lime	3047
Lime	3600
<u>ROTARY TOTAL DEPTH</u>	<u>3600</u>

RECEIVED  
STATE CORPORATION COMMISSION

JUN 15 1982  
06-15-1982  
CONSERVATION DIVISION  
Wichita Kansas

STATE OF Kansas )

COUNTY OF Sedgwick )

SS:

I, Wilson Rains, President of Rains & Williamson Oil Co., Inc.

upon oath state that the above and foregoing is a true and correct copy of the log of the  
Peavey #1 well.

Wilson Rains  
Wilson Rains

Subscribed and sworn to before me this 9 day of June, 1982.

My Appointment Expires:

10-4-83

Juanita M. Green  
Juanita M. Green

