


STATE OF KANSAS
STATE CORPORATION COMMISSION

WELL PLUGGING RECORD

Give All Information Completely
Make Required Affidavit
Mail or Deliver Report to
Conservation Division
State Corporation Comm.
245 North Water
Wichita, KS 67202

Rooks County, Sec. 32 Twp. 10S Rge. 18 E/W
Location as "NE/CNW $\frac{1}{4}$ SW $\frac{1}{4}$ " or footage from lines
SW SW SW

Lease Owner Petroleum Energy
Lease Name Peavey Well No. #1
Office Address 710 One Twenty Bldg. Wichita, Ks.
Character of Well (Completed as Oil, Gas or Dry Hole)
Dry Hole

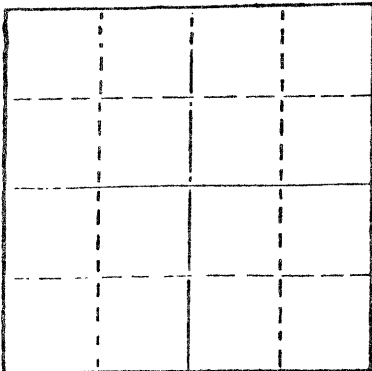

Locate well correctly on above
Section Plat

Date Well completed 4-22 1981
Application for plugging filed 4-22 1981
Application for plugging approved 4-22 1981
Plugging commenced 4-22 1981
Plugging completed 4-22 1981
Reason for abandonment of well or producing formation

If a producing well is abandoned, date of last production 19

Was permission obtained from the Conservation Division or its agents before plugging was commenced? Yes

Name of Conservation Agent who supervised plugging of this well Marion Smith
Producing formation Depth to top Bottom Total Depth of Well 3542
Show depth and thickness of all water, oil and gas formations.

OIL, GAS OR WATER RECORDS

CASING RECORD

FORMATION	CONTENT	FROM	TO	SIZE	PUT IN	PULLED OUT
				8 5/8"	220'	NONE


Describe in detail the manner in which the well was plugged, indicating where the mud fluid was placed and the method or methods used in introducing it into the hold. If cement or other plugs were used, state the character of same and depth placed, from feet to feet for each plug set.

- Mud to 720', 65 sx. cement.
- Mud to 240', 30 sx. cement.
- Mud to 40', 10 sx. cement.
- 5 sx. cement in rathole.

(If additional description is necessary, use BACK of this sheet)

Name of Plugging Contractor White & Ellis Drilling, Inc.
401 E. Douglas Suite 500 Wichita, Ks. 67202

STATE OF Kansas COUNTY OF Sedgwick, ss.
Ernest Sifford (employee of owner) or (owner or operator
of the above-described well, being first duly sworn on oath, says: That I have knowledge of the facts, statements, and matters herein contained and the log of the above-described well as filed and that the same are true and correct. So help me God.

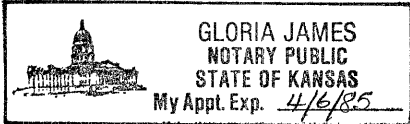

(Signature) Ernest Sifford
401 E. Douglas #500 Wichita, Ks. 67202
(Address)

SUBSCRIBED AND SWORN TO before me this 6th day of May, 19 81

My commission expires April 6, 1985

Gloria James
Gloria James Notary Public.

05-11-1981

DRILLERS LOG

15-163-21273-00-00

OPERATOR: Petroleum Energy, Inc. 710 One Twenty Bldg, Wichita, Ks.
CONTRACTOR: White & Ellis Drilling, Inc., Box 448, El Dorado, Kansas 67042 67202

Lease Name Peavey Well No. #1

Sec. 32 T. 10S R. 18W Spot SW SW SW

County Rooks State Kansas Elevation

Casing Record:

Surface: 8 5/8" @ 220' with 150 Sxs. 2%gel 3%cc

Production: @ with Sxs.

Type Well: D & A Total Depth 3542'

Drilling Commenced: 4-14-81 Drilling Completed 4-22-81

Formation	From	To	Tops
Cellar	0	7	
Shale	7	1675	
Shale, Lime	1675	3225	
Lime	3225	3542	

COMPLETION RECORD

Liner Record: Size From To

Cementing Record: Sacks

Perforating Record:

Formation	Perforated Interval	Number Shots

Initial Production:

Electric Log Type and Depths Covered
