


WELL PLUGGING RECORD

Give All Information Completely
Make Required Affidavit
Mail or Deliver Report to:
Conservation Division
State Corporation Commission
211 No. Broadway
Wichita, Kansas

NORTH

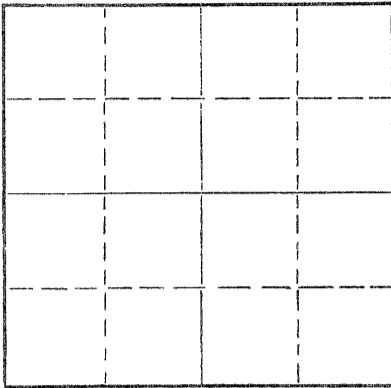

Locate well correctly on above
Section Plat

Rooks County, Sec. 34 Twp. 10S Rge. 18W (E) (W)

Location as "NE/CNW/SW" or footage from lines SE SE SW
Lease Owner Davis Bros. - Transit Corporation
Lease Name Wilson #31 Well No. 2
Office Address 1516 Liberty Bank Bldg., Oklahoma City, Oklahoma
Character of Well (completed as Oil, Gas or Dry Hole) Dry Hole
Date well completed March 5 1963
Application for plugging filed March 5 1963
Application for plugging approved March 5 1963
Plugging commenced March 5 1963
Plugging completed March 5 1963
Reason for abandonment of well or producing formation No production

If a producing well is abandoned, date of last production _____ 19____
Was permission obtained from the Conservation Division or its agents before plugging was commenced? Yes

Name of Conservation Agent who supervised plugging of this well Eldon Petty, Box 326, Hays, Kansas
Producing formation _____ Depth to top _____ Bottom _____ Total Depth of Well _____ Feet
Show depth and thickness of all water, oil and gas formations.

OIL, GAS OR WATER RECORDS

CASING RECORD

FORMATION	CONTENT	FROM	TO	SIZE	PUT IN	PULLED OUT
				8 5/8"	179'	None

Describe in detail the manner in which the well was plugged, indicating where the mud fluid was placed and the method or methods used in introducing it into the hole. If cement or other plugs were used, state the character of same and depth placed, from _____ feet to _____ feet for each plug set.

Filled hole with heavy drilling mud to 540', set plug, cemented with 20 sacks
Filled hole with heavy drilling mud to 180', set plug, cemented with 20 sacks
Filled hole with heavy drilling mud to 40', set plug, cemented with 10 sacks to bottom of cellar

RECEIVED
STATE CORPORATION COMMISSION

MAR 22 1963
03-22-1963

CONSERVATION DIVISION
Wichita, Kansas

(If additional description is necessary, use BACK of this sheet)

Name of Plugging Contractor Transit Corporation
Address 1516 Liberty Bank Bldg., Oklahoma City, Oklahoma

STATE OF Oklahoma, COUNTY OF Oklahoma, ss.
L. J. Kruse (employee of owner) or (~~owner or operator~~) of the above-described well, being first duly sworn on oath, says: That I have knowledge of the facts, statements, and matters herein contained and the log of the above-described well as filed and that the same are true and correct. So help me God.

(Signature) L. J. Kruse

SUBSCRIBED AND SWORN TO before me this 21st day of March, 19 63

(Address) _____
Paul E. Walters
Notary Public.

My commission expires January 3, 1966



15-163-02636-00-00

DRILLER'S WELL LOG

Davis Bros. • Transit Corporation

Wilson "B" # 2 located in
SE SE SW, Section 34-10S-18W,
Rooks County, Kansas

Commenced: February 26, 1963
Completed: March 5, 1963
Elevation: 2037' D.F.

Casing: 8 5/8" @ 182'
Cemented: w/125 sacks

<u>Formation</u>	<u>From</u>	<u>To</u>
Surface soil & post rock	0	75
Water sand	75	80
Clay and grey shale	80	105
Blue shale	105	182
Shale	182	450
Shale and shells	450	630
Shale w/sand streaks	630	745
Shale	745	890
Sand	890	950
Shale	950	1080
Sand	1080	1110
Shale	1110	1100
Anhydrite	1100	1135
Shale and shells	1135	1650
Shale	1650	1750
Shale and lime shells	1750	1940
Lime and shale	1940	2090
Lime	2090	2420
Lime and shale	2420	2530
Shale	2530	2675
Shale broken sand	2675	2775
Lime and shale	2775	2900
Shale w/lime streaks	2900	3010
Shale	3010	3035
Lime	3035	3538 T.D.

RECEIVED
STATE CORPORATION COMMISSION

MAR 22 1963
03-22-1963
CONSERVATION DIVISION
Wichita, Kansas

I hereby certify the foregoing to be a true and correct Driller's log of the formations encountered in the above well.

Subscribed and sworn to before me
this 21st day of March, 1963

TRANSIT CORPORATION

By L. J. Kruse

My commission expires January 3, 1966

Paul E. Ginders
Notary Public