


STATE CORPORATION COMMISSION

Get All Information Completely
Make Required Affidavit
Mail or Deliver Report to:
Conservation Division
State Corporation Commission
211 No. Broadway
Wichita, Kansas

15-163-00006-00-00
WELL PLUGGING RECORD

NORTH

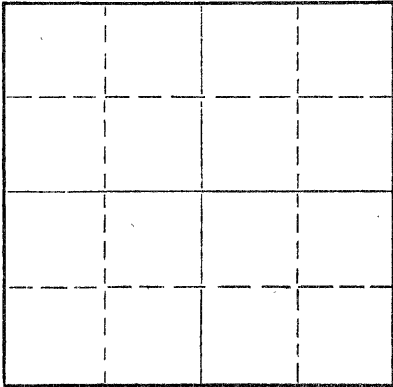

Locate well correctly on above
Section Plat

Rooks _____ County. Sec. 34 Twp. 10S Rge. 18W (E) _____ (W)
Location as "NE/CNW/SW" or footage from lines SW NE SW
Lease Owner Davis Bros. - Transit Corporation
Lease Name Wilson "B" # 1 Well No. 1
Office Address 1516 Liberty Bank Bldg., Oklahoma City 2, Oklahoma
Character of Well (completed as Oil, Gas or Dry Hole) Dry Hole
Date well completed December 31, 1961 19____
Application for plugging filed December 31, 1961 19____
Application for plugging approved December 31, 1961 19____
Plugging commenced January 2, 1962 19____
Plugging completed January 2, 1962 19____
Reason for abandonment of well or producing formation No production

If a producing well is abandoned, date of last production _____ 19____
Was permission obtained from the Conservation Division or its agents before plugging was commenced? Yes

Name of Conservation Agent who supervised plugging of this well Eldon Petty, Box 326, Hays, Kansas
Producing formation _____ Depth to top _____ Bottom _____ Total Depth of Well _____ Feet
Show depth and thickness of all water, oil and gas formations.

OIL, GAS OR WATER RECORDS

CASING RECORD

FORMATION	CONTENT	FROM	TO	SIZE	PUT IN	PULLED OUT
				8 5/8"	168'	None

Describe in detail the manner in which the well was plugged, indicating where the mud fluid was placed and the method or methods used in introducing it into the hole. If cement or other plugs were used, state the character of same and depth placed, from _____ feet to _____ feet for each plug set.

Fill hole with heavy drilling mud to 500', set plug, cemented with 20 sacks
Filled hole with heavy drilling mud to 160', set plug, cemented with 20 sacks
Filled hole with heavy drilling mud to 40', set plug, cemented with 10 sacks
to bottom of cellar

RECEIVED
FEB 7 1962
02-07-1962
CONSERVATION DIVISION
Wichita, Kansas

(If additional description is necessary, use BACK of this sheet)
Name of Plugging Contractor Transit Corporation
Address 1516 Liberty Bank Bldg., Oklahoma City 2, Oklahoma

STATE OF Oklahoma, COUNTY OF Oklahoma, ss.
L. J. Kruse (employee of owner) or (owner or operator) of the above-described well, being first duly sworn on oath, says: That I have knowledge of the facts, statements, and matters herein contained and the log of the above-described well as filed and that the same are true and correct. So help me God.

(Signature) L. J. Kruse

SUBSCRIBED AND SWORN TO before me this 10th day of January, 1962, 19____

My commission expires January 3, 1966 Paul E. Gathers Notary Public.

15-163-00006-00-00

DRILLER'S WELL LOG

Davis Bros.-Transit Corporation

Wilson "B" # 1 well, located in
SW NE SW, Section 34-10S-18W,
Rooks County, Kansas

Commenced: December 23, 1961
Completed: December 31, 1961
Elevation: 1989' K.B.

Casing: 8 5/8" @ 168'
Cemented w/125 sacks

<u>Formation</u>	<u>From</u>	<u>To</u>
Surface soil	0	90
Sand	90	95
Gray shale	95	120
Blue shale	120	168
Shale and shells	168	620
Sand and shale streaks	620	780
Shale w/Pyrite	780	835
Sand	835	1000
Shale w/Pyrite streaks	1000	1150
Red Bed	1150	1342
Anhydrite	1342	1377
Shale	1377	1405
Shale and shells	1405	1900
Shale and lime	1900	1935
Shale w/lime	1935	2060
Lime w/shale	2060	2240
Lime w/shale streaks	2240	2490
Lime and shale	2490	2530
Shale w/lime	2530	2720
Shale and lime	2720	2865
Shale	2865	2985
Lime w/shale	2985	3105
Lime	3105	3491
Conglomerate	3491	3546
Simpson shale	3546	3575
Arbuckle	3573	3600 TD

RECEIVED
STATE OF KANSAS
FEB 7 1962
02-07-1962
CONSERVATION DIVISION
Wichita, Kansas

I hereby certify the foregoing to be a true and correct Driller's
Log of the formations encountered in the above well.

Subscribed and sworn to before me
this 10th day of January, 1962

TRANSIT CORPORATION

By L. J. Krum

My commission expires January 3, 1966

Paul E. Galters
Notary Public