


15-163-02494-00-00

WELL PLUGGING RECORD

STATE OF KANSAS  
STATE CORPORATION COMMISSION  
Give All Information Completely  
Make Required Affidavit  
Mail or Deliver Report to:  
Conservation Division  
State Corporation Commission  
800 Bittling Building  
Wichita, Kansas

Rooks County. Sec. 34 Twp. 10S Rge. 18 (E) (W)

Location as "NE/CNW/SW" or footage from lines NE/4 NE/4 SE/4  
Lease Owner Heathman & Co., et al  
Lease Name Wilson Estate Well No. 1  
Office Address 509 Orpheum Building, Wichita, Kansas  
Character of Well (completed as Oil, Gas or Dry Hole) Dry Hole  
Date well completed March 25, 1952  
Application for plugging filed verbal March 25, 1952  
Application for plugging approved verbal March 25, 1952  
Plugging commenced March 25, 1952  
Plugging completed March 25, 1952  
Reason for abandonment of well or producing formation Dry Hole

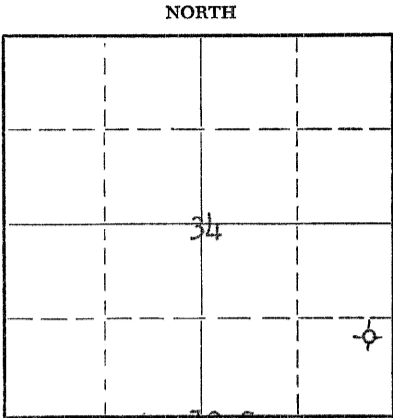

10 S  
Locate well correctly on above Section Plat

If a producing well is abandoned, date of last production 19  
Was permission obtained from the Conservation Division or its agents before plugging was commenced? Yes

Name of Conservation Agent who supervised plugging of this well Eldon Petty, Hays, Kansas  
Producing formation None Depth to top - Bottom - Total Depth of Well 3690 Feet  
Show depth and thickness of all water, oil and gas formations.

OIL, GAS OR WATER RECORDS

CASING RECORD

FORMATION	CONTENT	FROM	TO	SIZE	PUT IN	PULLED OUT
None				8 5/8"	150'	None
				cemented with 115 sacks cement		
				No oil string run - dry and abandoned		

Describe in detail the manner in which the well was plugged, indicating where the mud fluid was placed and the method or methods used in introducing it into the hole. If cement or other plugs were used, state the character of same and depth placed, from feet to feet for each plug set.

Filled hole with heavy mud to 150'. Set bottom plug at 150' and filled hole with 50 sacks cement up to bottom of cellar

(If additional description is necessary, use BACK of this sheet)

Name of Plugging Contractor Walters Drilling Co., Inc.  
Address 500 Orpheum Building, Wichita, Kansas

STATE OF KANSAS, COUNTY OF SEDGWICK, ss.  
ROBERT F. WALTERS (employee of owner) or (owner or operator) of the above-described well, being first duly sworn on oath, says: That I have knowledge of the facts, statements, and matters herein contained and the log of the above-described well as filed and that the same are true and correct. So help me God.

(Signature) Robert F. Walters  
500 Orpheum Building, Wichita, Kansas (Address)

SUBSCRIBED AND SWORN TO before me this 2nd day of April, 1952

My commission expires March 10, 1956 Notary Public.

PLUGGING  
FILE SEC 34 T 10 R 18 W  
BOOK PAGE 5 LIST 31

04-04-1952

15-163-02494-00-00

WILSON ESTATE WELL No. 1

Location:	NE NE SE Sec. 34-105-18W Rooks County, Kansas	Date Spudded:	3-10-52
Operator:	Hartman & Co.	Rotary Completion:	3-25-52
Contractor:	Walters Drilling Co., Inc.	Elevation:	2020'± 2030'± 2020'±
Surface Casings:	3 5/8" set at 150' with 115 sacks cement and 1 sack Gal. Chloride		
Oil Strings:	None		

**L O G**

(figures indicate bottom of formation)

Surface	0 to 150
Shale	156
Shale and Sand	1066
Anhydrite	1371
Shale and Shells	2385
Shale and lime	3527

The undersigned, Robert F. Walters, hereby certifies that the above log is a true and correct log of the formations encountered in drilling the above noted well as reflected by the Daily Drilling Reports.

WALTERS DRILLING CO., INC.

By Robert F. Walters

Subscribed and sworn to before me  
this 1st day of April, 1952.

Pauline Neudrick  
Notary Public

My commission expires:  
March 10, 1956

**PLUGGING**  
 FILE NO. 34-10-18W  
 5-31