

15-1103-03008-00-00

WELL PLUGGING RECORD

Give All Information Completely  
Make Required Affidavit  
Mail or Deliver Report to:  
Conservation Division  
State Corporation Commission  
800 Bitting Building  
Wichita, Kansas

Rooks County. Sec. 36 Twp. 10S Rge. (E) 18 (W)

Location as "NE/CNW $\frac{1}{4}$ SW $\frac{1}{4}$ " or footage from lines SE SW SW

Lease Owner Glenn W. Peel Oil Producer

Lease Name Kempe Well No. 3

Office Address P. O. Box 359, Hoisington, Kansas

Character of Well (completed as Oil, Gas or Dry Hole) Oil Well

Date well completed January 19, 19 54

Application for plugging filed June 3, 19 54

Application for plugging approved June 3, 19 54


Plugging commenced June 1, 19 54

Plugging completed June 5, 19 54

Reason for abandonment of well or producing formation No longer a commercial producer

If a producing well is abandoned, date of last production May 22, 19 54

Was permission obtained from the Conservation Division or its agents before plugging was commenced? Yes

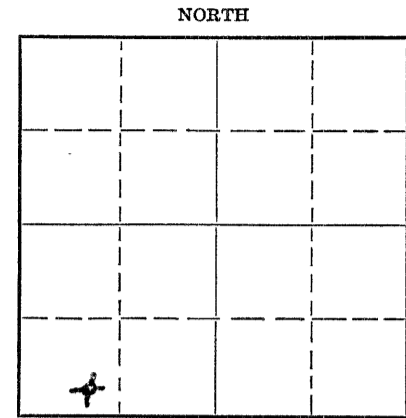

Locate well correctly on above Section Plat

Name of Conservation Agent who supervised plugging of this well Eldon Petty

Producing formation Arbuckle Depth to top 3636 Bottom 3642 Total Depth of Well 3642 Feet

Show depth and thickness of all water, oil and gas formations.

OIL, GAS OR WATER RECORDS

CASING RECORD

Formation	Content	From	To	Size	Put In	Pulled Out
		0	187	8 5/8"	187	None
		0	3639	5 1/2"	3638	2835

Describe in detail the manner in which the well was plugged, indicating where the mud fluid was placed and the method or methods used in introducing it into the hole. If cement or other plugs were used, state the character of same and depth placed, from \_\_\_\_\_ feet to \_\_\_\_\_ feet for each plug set.

Filled back to 3630' and dumped 4 sacks cement.

Pulled pipe, Mudded hole to 200', set rock bridge and dumped 15 sacks at 200'. Finished mudding hole and put in 10 sacks cement at top of surface.

(If additional description is necessary, use BACK of this sheet)

Name of Plugging Contractor Bert Self

Address RR #4, Hutchinson, Kansas

STATE OF Kansas, COUNTY OF Barton, ss.

William Herbert (employee of owner) of the above-described well,

being first duly sworn on oath, says: That I have knowledge of the facts, statements, and matters herein contained and the log of the above-described well as filed and that the same are true and correct. So help me God.

(Signature) *William Herbert*

P. O. Box 359, Hoisington, Kansas (Address)

SUBSCRIBED AND SWORN to before me this 17th day of June, 19 54

My commission expires June 4, 1955

*Margaret M. Herbert*  
STATE CORPORATION COMMISSION Notary Public.

23-8890-S 6-51-20M  
**PLUGGING**  
FILE SEC 36 T 10 R 18W  
BOOK PAGE 38 LINE 43

JUN 18 1954  
06-18-1954  
CONSERVATION DIVISION  
Wichita, Kansas

15-163-03008-00-00

DRILLER'S LOG

Company: Glenn W. Peel Oil Producer

SE SW SW

Farm Name: Kempe Well No. 3

Sec. 36, Twp. 10S, Rge. 18W,

Total Depth: 3642'

County: Rooks, Kansas

Comm: 12-26-53 Comp: 1-19-54

Elevation:

Contractor: Glenn W. Peel

Casing: 187' 8 5/8" cem.  
3639' 5 1/2" cem.

Production:

Figures below indicate bottoms of formation:

Surface soils	0 -	189
Shale		850
Sand		1030
Shale		1360
Anhydrite		1395
Shale		1960
Shale and Lime		3190
Lime		3575
Chirty Lime		3605
Lime and Shale		3642
Total Depth		3642

This is to certify that the above information is to the best of our knowledge, true and correct.

GLENN W. PEEL

BY: Max Herber

SUBSCRIBED AND SWORN to before me this 19th day of January, 1954.

My commission expires: June 4, 1955

Max M. Herber  
Notary Public

Moved in cable tools 1-14-54. Drilled cement and swabbed on 1-15-54; Finished drilling cement on 1-16-54; Acidized w/500 gals acid and swab tested. 1-18-54- checked fillup--1000 feet fluid in hole, acidized w/1000 gals., swab testing; 1-19-54--Checked fillup-1500' fluid in hole, tested approximately 3 1/2 bbls. per hr. Ran tubing and rods.

RECEIVED  
06-04-1954

PLUGGING  
TWP. 10 S. R. 18 W.  
PAGE 38 LINE 13