


Give All Information Completely
Make Required Affidavit
Mail or Deliver Report to:
Conservation Division
State Corporation Commission
800 Biting Building
Wichita, Kansas

15-163-02568-00-00
WELL PLUGGING RECORD

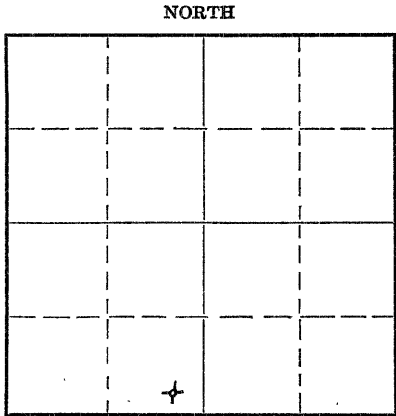

Locate well correctly on above Section Plat

Rooks _____ County. Sec. 36 Twp. 10S Rge. 18 (E) (W)
Location as "NE/CNW¹/₄SW¹/₄" or footage from lines SE SE SW
Lease Owner Glenn Peel Drilling Co., Inc.
Lease Name Kempe Well No. 2
Office Address P. O. Box 359 Hoisington, Kansas
Character of Well (completed as Oil, Gas or Dry Hole) Dry Hole
Date well completed January 2, 1951
Application for plugging filed January 2, 1951
Application for plugging approved January 2, 1951
Plugging commenced January 2, 1951
Plugging completed January 2, 1951
Reason for abandonment of well or producing formation Dry Hole

If a producing well is abandoned, date of last production _____ 19____
Was permission obtained from the Conservation Division or its agents before plugging was commenced? Yes

Name of Conservation Agent who supervised plugging of this well E. R. Petty Hays, Kansas
Producing formation _____ Depth to top _____ Bottom _____ Total Depth of Well 3655 Feet
Show depth and thickness of all water, oil and gas formations.

OIL, GAS OR WATER RECORDS

CASING RECORD

Formation	Content	From	To	Size	Put In	Pulled Out
		0	155'	8 5/8"	155'	None

Describe in detail the manner in which the well was plugged, indicating where the mud fluid was placed and the method or methods used in introducing it into the hole. If cement or other plugs were used, state the character of same and depth placed, from _____ feet to _____ feet for each plug set.

3655' - 151¹/₂' - Heavy Rotary Mud
151¹/₂' - 150' - Wooden Plug
150' - 104' - 15 Sacks Cement
104' - 36¹/₂' - Heavy Rotary Mud
36¹/₂' - 35' - Wooden Plug
35' - 6' - 10 Sacks Cement
6' - Surface-Cellar

STATE OF KANSAS
01-11-1951
JAN 11 1951
Conservation Division
Wichita, Kansas

(If additional description is necessary, use BACK of this sheet)

Correspondence regarding this well should be addressed to Glenn W. Peel Oil Producer
Address P. O. Box 359, Hoisington, Kansas

STATE OF Kansas, COUNTY OF Barton, ss.
Glenn Peel Drilling Company, Inc. (employee of owner) or (owner or operator) of the above-described well,
being first duly sworn on oath, says: That I have knowledge of the facts, statements, and matters herein contained and the log of the above-described well as filed and that the same are true and correct. So help me God. GLENN PEEL DRILLING COMPANY, INC.

(Signature) BY: *[Signature]*
P. O. Box 359 HOISINGTON, KANSAS
(Address)

SUBSCRIBED AND SWORN to before me this 9th day of January, 19 51

[Signature]
Notary Public.

My commission expires June 4, 1951

PLUGGING
FILE SEC 36 T 10 R 120
BOOK PAGE 53 LINE 71

15-163-02568-00-00

DRILLER'S LOG

Company: Glenn W. Peel Oil Producer, John Wenzel,
& R. C. McCormick

SE SE SW
Sec. 36 Twp. 10S Rge. 18W

Farm: Kempe Well No. 2

Comm: 12-22-50 Comp: 1-2-51

County: Rooks,
Kansas

Contractor: Glenn Peel Drilling Co., Inc.

Total Depth: 3655'

Elevation:

Casing:

8 5/8" 155' cem.

Production: Dry

Figures below indicate bottom of formations

Rock & Shale	0-	60
Sand		110
Shale & Shells		156
Shale		240
Sand & Shale		320
Shale & Shells		480
Sand & Shale		520
Shale & Shells		855
Sand		1055
Sand & Shale		1125
Shale		1355
Anhydrite		1402
Shale & Shells		1655
Shale & Lime Shells		1845
Broken Lime & Shale		2010
Lime		2028
Shale & Lime		2240
Lime		2450
Lime & Shale		2655
Lime		2755
Lime & Shale		3145
Lime		3655
Total Depth		3655

This is to certify that the above information is, to the best of our knowledge true and correct.

GLENN PEEL DRILLING COMPANY, INC.

BY: *J. B. [Signature]*

SUBSCRIBED AND SWORN to before me this 9th day of January, 1951

My commission expires June 4, 1951

Marion M. Herlet
Notary Public

RECEIVED
STATE COMMISSION

JAN 11 1951
01-11-1951
CONSERVATION DIVISION
Wichita, Kansas

PLUGGING
FILE SEC 36 T 10 R 18W
BOOK PAGE 53 LINE 21