

15-163-02694-00-00

STATE OF KANSAS
STATE CORPORATION COMMISSION


WELL PLUGGING RECORD

Give All Information Completely
Make Required Affidavit
Mail or Deliver Report to:
Conservation Division
State Corporation Commission
800 Biting Building
Wichita, Kansas

OR

~~FORMATION PLUGGING RECORD~~ Strike out upper line when reporting plugging off formations.

NORTH

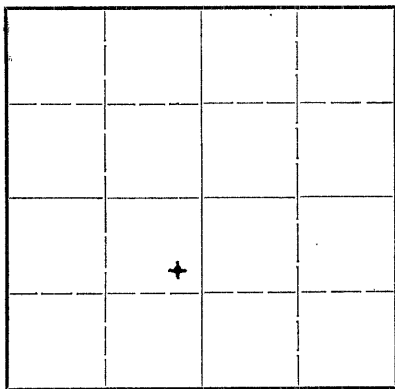

Locate well correctly on above Section Plat

Rooks County. Sec. 35 Twp. 10 S. Rge. 18 W. (W)
Location as "NE 1/4 NW 1/4 SW 1/4" or footage from lines. SE - NE - SW
Lease Owner. Sunray Oil Corporation
Lease Name. Geil Wilson "B" Well No. 2
Office Address. Box 195, Great Bend, Kansas
Character of Well (completed as Oil, Gas or Dry Hole). Dry Hole
Date well completed. 5/14/47 19
Application for plugging filed. 5/15/47 19
Application for plugging approved. 5/16/47 19
Plugging commenced. 5/14/47 19
Plugging completed. 5/14/47 19
Reason for abandonment of well or producing formation. Dry

If a producing well is abandoned, date of last production. 19
Was permission obtained from the Conservation Division or its agents before plugging was commenced? Yes

Name of Conservation Agent who supervised plugging of this well. C. D. Stough, Box 105, Hays, Kansas
Producing formation. Depth to top. 3663 Bottom. Total Depth of Well 3673 Feet
Show depth and thickness of all water, oil and gas formations.

OIL, GAS OR WATER RECORDS

CASING RECORD

Formation	Content	From	To	Size	Put In	Pulled Out
Arbuckle	Water	3663	3673	8-5/8"	1408'	None

Describe in detail the manner in which the well was plugged, indicating where the mud fluid was placed and the method or methods used in introducing it into the hole. If cement or other plugs were used, state the character of same and depth placed, from feet to feet for each plug set.

Plugged w/15 sax cement at 1400' & 10 sax at top.

(If additional description is necessary, use BACK of this sheet)

Correspondence regarding this well should be addressed to Sunray Oil Corporation Box 195, Great Bend, Kansas
Address.

STATE OF KANSAS, COUNTY OF BARTON, ss.

Louis I. Moffatt

(employee of owner) or ~~owner~~ of the above-described well,

being first duly sworn on oath, says: That I have knowledge of the facts, statements, and matters herein contained and the log of the above-described well as filed and that the same are true and correct. So help me God.

(Signature)

Louis I. Moffatt

Box 195, Great Bend, Kansas

(Address)

SUBSCRIBED AND SWORN to before me this 20 day of

May

Viola Beck 05 21 1947

My commission expires June 10, 1950

Notary Public.

21-871-s 9-15-6M

PLUGGING
FILE SEC 35 T 10 R 18 W
BOOK PAGE 110 LINE 4

15-163-02694-00-00

May 17, 1947

Sunray Oil Corporation
Piltower Building
Tulsa, Oklahoma

Wilson "B" 2

32 000 SW/4 NW/4
Sec 35-105-18W
Rocks County, Kansas

CONTRACTOR: Stickle Drilling Company, Tulsa, Oklahoma

Started: April 29, 1947

Finished: May 14, 1947

DRILLER'S LOG

Cellar	0	4	
Surface sand & clay	4	188	
Shale & shells	188	608	
Sand	608	665	
Shale & shells	665	800	
Sand	800	1080	
Shale & shells	1080	1245	
Sand, shale & shells	1245	1401	
anhydrite	1401	1440	1408' of 8-5/8" csg. cemented
Red Rock	1440	1580	w/ 600 sacks of bulk.
Shale & shells	1580	1975	
salt	1975	2080	
Shale	2080	2150	
Shale & lime	2150	2310	
Lime	2310	2950	
Lime & shale	2950	3040	
Lime	3040	3455	
Lime & shale	3455	3482	
Lime	3482	3610	
Conglomerate	3610	3625	
Conglomerated Simpson shale	3625	3657	
Shale & Lime	3657	3675	20' (20' of 3673')

Plugged per orders w/ 15 sacks at 1400' and 10 sacks at top.

State of Kansas ()
County of Barton (ss)

I, Fred A. Stickle, do hereby certify that the above is a true and complete log of Sunray Oil Corporation's "B" #2 Wilson, located in the SW cor. NE/4 SW/4 Sec. 35-105-18W Rocks County, Kansas

Fred A. Stickle

Sworn to and subscribed before me this 19th day of May, 1947

Viola Beck
Notary Public

PLUGGING
FILE SEC 35 T 10 R 18W
BOOK PAGE 110 LINE 4

MAY 21 1947
05-21-1947