

WELL PLUGGING RECORD

Give All Information Completely  
Make Required Affidavit  
Mail or Deliver Report to  
Conservation Division  
State Corporation Comm.  
200 Colorado Derby Bldg.  
202 W. 1st St.  
Wichita, KS 67202

Rooks County Sec. 2 Twp. 10s Rge. 19 K/W  
Location as "NE/CNW/SW" or footage from lines \_\_\_\_\_

SW NE NW

Lease Owner Graves Drilling Company

Lease Name Smee Well No. #2

Office Address 910 Union Center Wichita, Ks 67202

Character of Well (Completed as Oil, Gas or Dry Hole) \_\_\_\_\_  
Dry Hole

Date Well completed November 15 1981

Application for plugging filed November 15 1981

Application for plugging approved November 15 1981

Plugging commenced 7:45 A.M. November 15 1981


Plugging completed 9:15 A.M. November 15 1981

Reason for abandonment of well or producing formation \_\_\_\_\_  
No Commercial Production

If a producing well is abandoned, date of last production \_\_\_\_\_ 19 \_\_\_\_\_

Was permission obtained from the Conservation Division or its agents before plugging was commenced? Yes

Name of Conservation Agent who supervised plugging of this well Marion Schmidt  
Producing formation \_\_\_\_\_ Depth to top \_\_\_\_\_ Bottom \_\_\_\_\_ Tl. Depth of Well \_\_\_\_\_  
Show depth and thickness of all water, oil and gas formations.

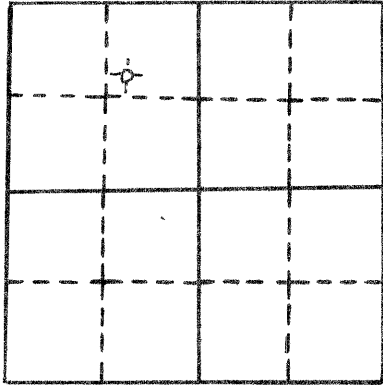

locate well correctly  
on above  
Section Plot

OIL, GAS OR WATER RECORDS

CASING RECORD

| FORMATION      | CONTENT | FROM | TO      | SIZE   | PUT IN  | PULLED OUT |
|----------------|---------|------|---------|--------|---------|------------|
| Surface casing | common  | 0'   | 210.84' | 8 5/8" | 210.84' | 0'         |
|                |         |      |         |        |         |            |
|                |         |      |         |        |         |            |
|                |         |      |         |        |         |            |

Describe in detail the manner in which the well was plugged, indicating where the mud fluid was placed and the method or methods used in introducing it into the hold. If cement or other plugs were used, state the character of same and depth placed, from \_\_\_\_\_ feet to \_\_\_\_\_ feet for each plug set.

RECEIVED  
STATE CORPORATION COMMISSION

DEC - 2 1981

12-2002-1981  
CONSERVATION DIVISION  
Wichita, Kansas

Plug #1 840' with 70sxs

Plug #2 210' with 40sxs

Plug #3 40' with 10sxs

10sxs in rathole

Total---- 130sxs 50-50pos 4%gel 3%cc

P.D. @ 9:15 A.M.

(If additional description is necessary, use BACK of this sheet)

Name of Plugging Contractor Pioneer Drilling Company Inc.  
308 West Mill Plainville, Ks 67663

STATE OF KANSAS COUNTY OF SEDGWICK, ss.

Betty Brandt (employee of owner) or (XXXXXXXXXXXXXXXXXXXX) of the above described well, being first duly sworn on oath, says: That I have knowledge of the facts, statements, and matters herein contained and the log of the above described well is filed and that the same are true and correct. So help me God.

(Signature) Betty Brandt

(Address) 910 Union Center

SUBSCRIBED AND SWORN TO before me this 30 day of November, 1981

My commission expires May 17, 1983

Rebecca L. Matthews  
Notary Public  
Rebecca L. Matthews