Form CP-4
Rev. 12-15-80

STATE OF KANSAS
STATE CORPORATION COMMISSION
200 Colorado Derby Bldg.
Wichita, Kansas 67202

15-163-19158-00-01

WELL PLUGGING RECORD

Give All Information Completely
Make Required Affidavit

COUNTY Rooks SEC. 28 TWP. 8 RGE. 19 E/W
Location as in quarters or footage from lines:
E/2 NW SE

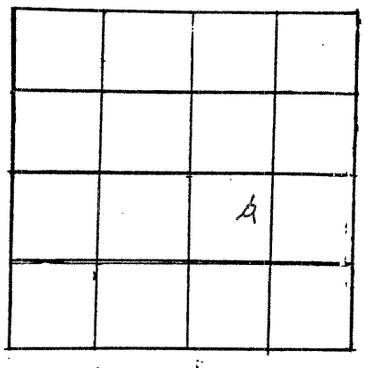

Locate Well correctly on above Section Platt.

Lease Owner Monsanto Oil Company
Lease Name Stice Well No. 2
Office Address 3545 NW 58th, Oklahoma City, Oklahoma 73112
Character of Well (Completed as Oil, Gas or Dry Hole): SWD
Date Well Completed May 20, 1959
Application for plugging filed 9-9-83
Plugging commenced 9-6-83
Plugging completed 9-6-83
Reason for abandonment of well or producing formation
No longer suitable for salt water disposal
Was permission obtained from the Conservation Division or it's Agent's before plugging was commenced? Yes

Name of Conservation Agent who supervised plugging of this well Carl Goodrow
~~Producing~~ Injection formation Cedar Hills Depth to top 1030 bottom 1090 T.D. 1200'

Show depth and thickness of all water, oil and gas formations.

OIL, GAS OR WATER RECORDS — Casing Record

Formation	Content	From	To	Size	Put in	Pulled Out
Cedar Hills	Salt Water	1030	1090	8 5/8"	180'	0
				5 1/2"	3456'	0
				4 1/2"	1100'	0

Describe in detail the manner in which the well was plugged, indicating where the mud fluid was placed and the method or methods used in introducing it into the hold. If cement or other plugs were used, state the character of same and depth placed, from _____ feet to _____ feet for each plug set. Pumped 200 Sx 50/50 Poz + 2% gel down 4 1/2" Casing from surface and pressured to 1000#. Pumped 100 Sx. down 8 5/8" X 5 1/2" annulus at 200#

RECEIVED
STATE CORPORATION COMMISSION
SEP 14 1983 9/14/83
CONSERVATION DIVISION
Wichita, Kansas

(If additional description is necessary, use BACK of this sheet)
Name of Plugging Contractor Allied Cementing Company, Inc.

STATE OF Oklahoma COUNTY OF Oklahoma ,ss.
Paul Harryman (employee of owner) or (owner or operator) of the above-described well, being first duly sworn on oath, says: That I have knowledge of the facts, statements, and matters herein contained and the log of the above-described well as filed and that the same are true and correct. So help me God.

(Signature) Paul Harryman
3545 NW 58th, Oklahoma City, Okla 73112
(Address)

SUBSCRIBED AND SWORN TO before me this 9th day of September, 19 83

Julie Forbes
Notary Public.

My Commission expires: 8-31-85