


WELL PLUGGING RECORD

Give All Information Completely  
Make Required Affidavit  
Mail or Deliver Report to:  
Conservation Division  
State Corporation Commission  
211 No. Broadway  
Wichita, Kansas

NORTH

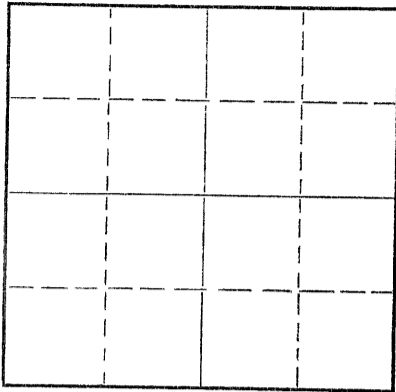

Locate well correctly on above  
Section Plat

ROOKS County. Sec. 30 Twp. 8S Rge. 19W (E) (W)  
Location as "NE/CNW/SW" or footage from lines SE SE NE  
Lease Owner KAISER - FRANCIS  
Lease Name LOWRY Well No. 1  
Office Address 905 PALACE BLDG, TULSA, OKLA.  
Character of Well (completed as Oil, Gas or Dry Hole) D & A  
Date well completed 10-13-58 19\_\_  
Application for plugging filed 10-13-58 19\_\_  
Application for plugging approved 10-13-58 19\_\_  
Plugging commenced 10-13-58 19\_\_  
Plugging completed 10-13-58 19\_\_  
Reason for abandonment of well or producing formation \_\_\_\_\_

If a producing well is abandoned, date of last production \_\_\_\_\_ 19\_\_  
Was permission obtained from the Conservation Division or its agents before plugging was commenced? yes

Name of Conservation Agent who supervised plugging of this well Eldon Petty  
Producing formation \_\_\_\_\_ Depth to top \_\_\_\_\_ Bottom \_\_\_\_\_ Total Depth of Well 3507' Feet  
Show depth and thickness of all water, oil and gas formations.

OIL, GAS OR WATER RECORDS

CASING RECORD

FORMATION	CONTENT	FROM	TO	SIZE	PUT IN	PULLED OUT
				8-5/8"	225'	

Describe in detail the manner in which the well was plugged, indicating where the mud fluid was placed and the method or methods used in introducing it into the hole. If cement or other plugs were used, state the character of same and depth placed, from \_\_\_\_\_ feet to \_\_\_\_\_ feet for each plug set.

Filled with heavy mud to 600' set plug with 20 sx cement thru drill pipe. Fill with heavy mud to 210' set plug with 1/2 sx hulls and 20 sx cement. Fill with heavy mud to 40' set solid bridge with 10 sx cement to base of cellar.  
Job. Complete.

(If additional description is necessary, use BACK of this sheet)  
Name of Plugging Contractor K & E DRILLING, INC.  
Address 719 Union Center, Wichita 2, Kansas

STATE OF OKLAHOMA, COUNTY OF TULSA, SS.

(employee of owner) or (owner or operator) of the above-described well, being first duly sworn on oath, says: That I have knowledge of the facts, statements, and matters herein contained and the log of the above-described well as filed and that the same are true and correct. So help me God.

(Signature) HERMAN GEO. KAISER, OIL PRODUCER  
Herman Geo. Kaiser  
905 Palace Building, Tulsa, Oklahoma  
(Address)

SUBSCRIBED AND SWORN TO before me this 22 day of October, 1958

My commission expires 7/9/60

RECEIVED  
STATE CORPORATION COMMISSION  
10-23-1958  
OCT 23 1958

Notary Public.

PLUGGING  
FILE SEC 30 T 8 R 19W  
BOOK PAGE 36 LINE 36

CONSERVATION DIVISION  
Wichita, Kansas

DRILLER'S LOG

OPERATOR: KAISER - FRANCIS  
 905 Palace Building  
 Tulsa, Oklahoma

CONTRACTOR: K & E DRILLING, INC.  
 719 Union Center  
 Wichita 2, Kansas

CASING: 5-5/8" \* 225' (150 sk)

R.T.D. 3507'

FARM NAME: #1 LOWRY

LOCATION: SE SE SE  
 Sec. 30-28-19W  
 Rocks County, Kansas

COMMENCED: 10-4-58  
 COMPLETED: 10-13-58

ELEVATION: 2004' KB  
 PRODUCTION: D & A

FORMATION RECORD


Depth indicates bottom of formations encountered.

Post Rock	45
Shale & Shells	225
Shale	325
Sand & Shale	540
Sand	1288
Shale & Shells	1455
Anhydrite	1455-1490
Sand & Shells	1955
Shale & Lime	2180
Lime	2385
Lime & Shale	2720
Lime	2820
Lime & Shale	3145
Lime	3420
Lime & Conglomerate	3470
Lime	3507
R.T.D.	3507

CERTIFICATION

STATE OF KANSAS )  
 ) SS:  
 COUNTY OF SEDGWICK )

I, Dale Silcott, of K & E DRILLING, INC., upon oath state that the above and foregoing is a true and correct copy of the Driller's Log of the KAISER FRANCIS #1 LOWRY well.

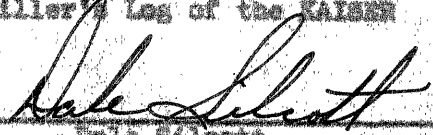  
 Dale Silcott

Subscribed and sworn to before me this 20th day of October, 1958.

  
 Patricia M. Edwards, Notary Public

My commission expires: August 11th, 1962.

PLUGGING  
 FILE SEC. 30 T. 8 R. 19W  
 BOOK PAGE 136 LINE 36