


Give All Information Completely
Make Required Affidavit
Mail or Deliver Report to:
Conservation Division
State Corporation Commission
212 No. Market
Wichita, Kansas

WELL PLUGGING RECORD

NORTH

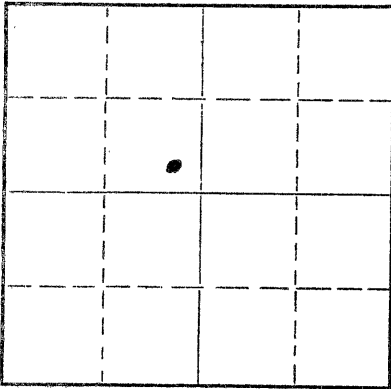

Locate well correctly on above Section Plat

Rooks County. Sec. 30 Twp. 8 Rge. ~~XX~~ 19 (W)

Location as "NE/CNW/SW" or footage from lines SE-SE-NW
Lease Owner Publishers Petroleum, Div. Okla. Publishing Co.
Lease Name Schrekinger Well No. 1
Office Address Box 25125 Okla. City, Okla. 73125
Character of Well (completed as Oil, Gas or Dry Hole) Dry Hole
Date well completed July 29 1975
Application for plugging filed (verbal application) July 28 1975
Application for plugging approved July 28 1975
Plugging commenced 3:00 A.M. July 29 1975
Plugging completed 4:00 A.M. July 29 1975
Reason for abandonment of well or producing formation Dry Hole

If a producing well is abandoned, date of last production None 19
Was permission obtained from the Conservation Division or its agents before plugging was commenced? Yes

Name of Conservation Agent who supervised plugging of this well Leo Massey
Producing formation None Depth to top Bottom Total Depth of Well 3540 Feet
Show depth and thickness of all water, oil and gas formations.

OIL, GAS OR WATER RECORDS

CASING RECORD

FORMATION	CONTENT	FROM	TO	SIZE	PUT IN	PULLED OUT
Surface		0	248	8 5/8"		

Describe in detail the manner in which the well was plugged, indicating where the mud fluid was placed and the method or methods used in introducing it into the hole. If cement or other plugs were used, state the character of same and depth placed, from feet to feet for each plug set.

With use of Halliburton, mixed 100 sacks of cement with 50-50 poz. and 6% gel.
Set first plug at 600 feet with 70 sacks pumped through drill pipe. Set second plug at 240 feet with 20 sacks pumped through drill pipe. Built a bridge in surface pipe at 40 feet and filled to surface with 10 sacks.

RECEIVED
STATE CORPORATION COMMISSION

AUG 1 1975
08-01-1975
CONSERVATION DIVISION
WICHITA, KANSAS

(If additional description is necessary, use BACK of this sheet)

Name of Plugging Contractor Halliburton Services
Address Drawer 1431 Duncan, Okla. 73533 (used Hays, Kansas Office)


STATE OF Kansas, COUNTY OF Graham, ss.
Jerry M. Helberg

(employee of owner) or (owner or operator) of the above-described well, being first duly sworn on oath, says: That I have knowledge of the facts, statements, and matters herein contained and the log of the above-described well as filed and that the same are true and correct. So help me God.

(Signature)

Jerry M. Helberg
Box 32 Morland, Kansas 67650
(Address)

SUBSCRIBED AND SWORN TO before me this 31 day of July, 1975

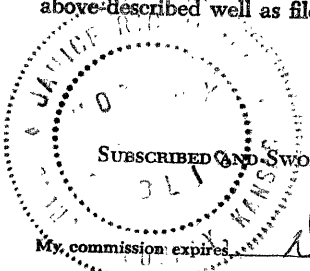

Jamie Robinson
Notary Public.