


STATE OF KANSAS
STATE CORPORATION COMMISSION

Give All Information Completely
Mistake Required Affidavit
Mail or Deliver Report to:
Conservation Division
State Corporation Commission
800 Bitting Building
Wichita, Kansas

OR
FORMATION PLUGGING RECORD

Strike out upper line
when reporting plugging
of formations.

NORTH

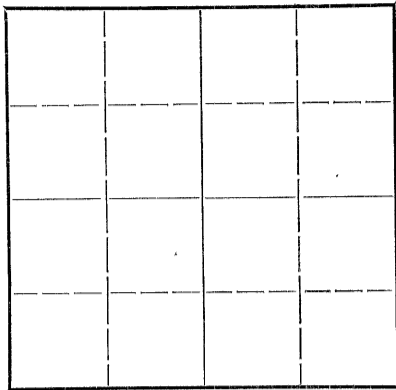

Locate well correctly on above
Section Plat

Rooks County. Sec. 31 Twp. 8 Rge. 19 (E) W (W)
Location as "NE 1/4 NW 1/4 SW 1/4" or footage from lines. NW 1/4 SE 1/4 NE 1/4 Sec 31
Lease Owner. Jack Heathman
Lease Name. Heathman, Ondrosek Well No. 2
Office Address. Orpheum Bldg., Wichita, Kansas.
Character of Well (completed as Oil, Gas or Dry Hole) Dry Hole
Date well completed. 19.
Application for plugging filed. 19.
Application for plugging approved. 19.
Plugging commenced. Sept. 9, 1949 19.
Plugging completed. Sept. 14, 1949 19.
Reason for abandonment of well or producing formation. Non productive.
If a producing well is abandoned, date of last production. Dry hole 19.
Was permission obtained from the Conservation Division or its agents before plugging was commenced? yes.

Name of Conservation Agent who supervised plugging of this well. Eldon Petty
Producing formation. None. Depth to top. Bottom. Total Depth of Well. Feet
Show depth and thickness of all water, oil and gas formations.

OIL, GAS OR WATER RECORDS

CASING RECORD

Formation	Content	From	To	Size	Put In	Pulled Out

Describe in detail the manner in which the well was plugged, indicating where the mud fluid was placed and the method or methods used in introducing it into the hold. If cement or other plugs were used, state the character of same and depth placed, from 3100 feet to surface. feet for each plug set.

Twenty six feet of cement was placed by dump bailer between 3100 feet and 3074 feet; Pipe collapsed at 2940, and hole filled with mud to 2771. Pipe shot off at 2690. Mud from slush pond poured in hole, to fill hole with mud from 2771 to 154 feet. Rock bridge installed and fifteen sacks of cement poured to form cement plug between 154 and 105 feet. Filled with surface earth between 105 feet to 25 feet. Hole cemented from 25 feet to top of surface pipe and capped. Plugging complete. Pipe pulled and hole plugged by Barnes and Sons Pipe Pulling Company, Russell, Kansas.

RECEIVED
Conservation Div.

9/23/49

SEP 23 1949

(If additional description is necessary, use BACK of this sheet)

Correspondence regarding this well should be addressed to Jack Heathman
Address. Orpheum Bldg., Wichita, Kansas.

STATE OF Kansas, COUNTY OF Russell, ss.
J.R. Barnes, Employee of owner (employee of owner) or (owner or operator) of the above-described well, being first duly sworn on oath, says: That I have knowledge of the facts, statements, and matters herein contained and the log of the above-described well as filed and that the same are true and correct. So help me God.

(Signature) J.R. Barnes

(Address)

SUBSCRIBED AND SWORN to before me this 15th day of September 19 49

Charles Boyle
Notary Public.

My commission expires Feb. 9, 1950

PLUGGING
FILE SEC 31 T 8 R 19 W
BOOK PAGE 115 LINE 8

15-163-02496-00-00 70901

T. ONDRASEK # 2 WELL

Location: Approx. Ctr. NW/4 SE/4 NE/4 Sec. 31-
8S-19W, Rooks Co., Kansas

Date Spudded: 7-7-49

Operator: Heathman Drilling Co., Inc.

Rotary Completion Date: 7-17-49

Contractor: Heathman Drilling Co., Inc.

Rotary T. D.: 3509'

Surface Casing: 5 jts. (156') 8-5/8" cemented
@ 152.52' w/125 sacks cement
and 1 sack Calcium Chloride.
Cement circulated.

Elevation: 2051 DF
2053 KB

Oil String: 87 jts. (3525.88' overall) 5-1/2"
8 Rd. Thd. cemented w/100 sacks
@ 3508' (1' off bottom)

T O P S

Anhydrite	1521 (+ 532)
Topeka	3002 (- 949)
Heebner	3220 (-1167)
Lansing-K.C.	3260 (-1207)
Base of K.C.	3479 (-1426)
Arbuckle	3507 (-1454)
Rotary T.D.	3509'

L O G

(Figures indicate bottom of formation)

Shale and sand	0 to 154
Shale	775
Sand	823
Sand and shale	1003
Sand	1288
Shale and shells	1521
Anhydrite	1560
Shale shells	1760
Shale and lime shells	1915
Lime and shale	3280
Lime	3391
Lime and shale	3509
Total Depth	3509

RECEIVED

October 19, 1949

OCT 19 1949

10/19/49

STATE CORPORATION
COMMISSION
KANSAS

The undersigned, Robert F. Walters of the Heathman Drilling Co., Inc., hereby certifies that the above log is a true and correct log of the formations encountered in drilling the above well as reflected by the Daily Drilling Reports.

HEATHMAN DRILLING CO., INC.

By: Robert F. Walters
Robert F. Walters

Subscribed and sworn to before me this 22nd day of July 1949.

D. Marjorie Mott
Notary Public

My commission expires: June 28, 1952.

PLUGGING
FILE NO. 3178-1949
BOOK PAGE 115-8