


Give All Information Completely  
Make Required Affidavit  
Mail or Deliver Report to:  
Conservation Division  
State Corporation Commission  
800 Bitting Building  
Wichita, Kansas

15-163-00586-00-00  
WELL PLUGGING RECORD

NORTH

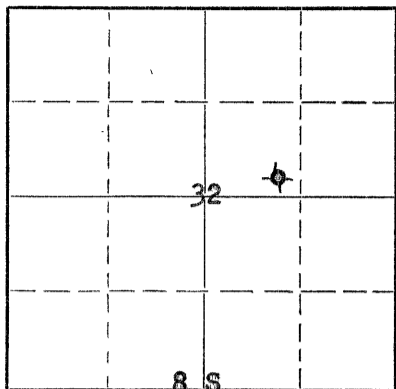

Locate well correctly on above  
Section Plat

Rooks County. Sec. 32 Twp. 8S Rge. 19 (E) (W)  
Location as "NE/CNW/SW" or footage from lines SE/4 SW/4 NE/4  
Lease Owner Walters Drilling Co., Inc.  
Lease Name Lowry Well No. 1  
Office Address 510 Orpheum Building, Wichita, Kansas  
Character of Well (completed as Oil, Gas or Dry Hole) Dry Hole  
Date well completed December 20, 19 52  
Application for plugging filed (verbal) December 20, 19 52  
Application for plugging approved (verbal) December 20, 19 52  
Plugging commenced December 20, 19 52  
Plugging completed December 20, 19 52  
Reason for abandonment of well or producing formation Dry Hole

If a producing well is abandoned, date of last production \_\_\_\_\_ 19 \_\_\_\_  
Was permission obtained from the Conservation Division or its agents before plugging was commenced? Yes

Name of Conservation Agent who supervised plugging of this well Eldon Petty, Hays, Kansas  
Producing formation None Depth to top \_\_\_\_\_ Bottom \_\_\_\_\_ Total Depth of Well 3705' Feet  
Show depth and thickness of all water, oil and gas formations.

OIL, GAS OR WATER RECORDS

CASING RECORD

FORMATION	CONTENT	FROM	TO	SIZE	PUT IN	PULLED OUT
		0	145'	8 5/8	145'	None
		cemented with 100 sacks cement and 1 Gal. Chloride				
		(no oil string - dry and abandoned)				

Describe in detail the manner in which the well was plugged, indicating where the mud fluid was placed and the method or methods used in introducing it into the hole. If cement or other plugs were used, state the character of same and depth placed, from \_\_\_\_\_ feet to \_\_\_\_\_ feet for each plug set.

Set bottom plug at 140' with 15 sacks cement and 1/2 sack Hulls.

Set top plug at 40' with 10 sacks cement and 1/2 sack Hulls.

RECEIVED  
CORPORATION COMMISSION  
JAN 2 1953  
CONSERVATION DIVISION  
Wichita, Kansas

1/2/53

(If additional description is necessary, use BACK of this sheet)  
Name of Plugging Contractor Walters Drilling Co., Inc.  
Address 510 Orpheum Building, Wichita, Kansas

STATE OF KANSAS, COUNTY OF SEDGWICK, ss.  
Robert F. Walters (employee of owner) or (~~owner or operator~~) of the above-described well, being first duly sworn on oath, says: That I have knowledge of the facts, statements, and matters herein contained and the log of the above-described well as filed and that the same are true and correct. So help me God.  
(Signature) Robert F. Walters  
510 Orpheum Building, Wichita, Kansas  
(Address)

SUBSCRIBED AND SWORN to before me this 31st day of December, 19 52

My commission expires March 10, 1956 Pauline Hedrickson Notary Public.

PLUGGING  
FILE SEC 3278 R 1952  
BOOK PAGE 68 LINE 42

15-163-00586-00-00

LOWRY NO. 1

Location: SE SW NE Sec. 32-8S-19W Rooks County, Kansas Date Spudded: 12-10-52

Operator: Walters Drilling Co., Inc. Rotary Completion: 12-20-52

Contractor: Walters Drilling Co., Inc. Elevation: 2064' Gr; 2067 DF; 2069 KB

Surface Casing: 8 5/8" set at 145' with 100 sacks cement and 1 sack Cal. Chloride

Oil String: None. D & A

LOG

(Figures indicate bottom of formation)

Surface	0 to 145
Shale and Shells	595
Sand	685
Shale	855
Shale and Shells	996
Sand	1242
Shale and Shells	1509
Anhydrite	1547
Shale and Shells	2040
Shale and Lime	2455
Shale and Shells	2530
Lime	2710
Lime and Shale	2810
Lime	2881
Lime and Shale	3205
Lime	3513
Shale and Lime	3590
Conglomerate and chert	3632
Lime and Shale	3705
Total Depth (Rotary)	3705

The undersigned, Robert F. Walters, hereby certifies that the above log is a true and correct log of the formations encountered in the drilling of the above noted well as reflected by the Daily Drilling Reports.

WALTERS DRILLING CO., INC.

By

Robert F. Walters

Subscribed and sworn to before me this 31st day of December, 1952.

Pauline Kuschick  
Notary Public

My commission expires: March 10, 1956

RECEIVED  
 CONSERVATION COMMISSION  
 JAN 2 - 1953  
 CONSERVATION DIVISION  
 Wichita, Kansas  
 1/2/53

**PLUGGING**  
 SEC 32 T 8 R 19 S 1  
 BOOK PAGE 68 LINE 42