


STATE OF KANSAS
STATE CORPORATION COMMISSION

Give All Information Completely
Make Required Affidavit
Mail or Deliver Report to:
Conservation Division
State Corporation Commission
800 Bitting Building
Wichita, Kansas

15-163-02998-00-00

WELL PLUGGING RECORD

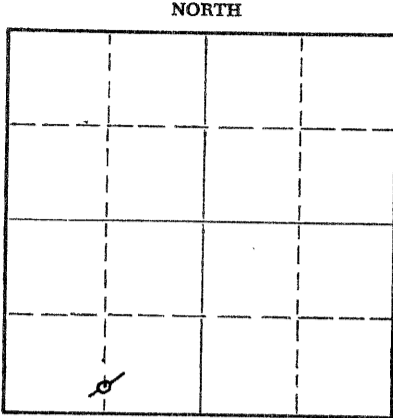

Locate well correctly on above
Section Plat

Rooks County. Sec. 35 Twp. 9S Rge. 19W(E) (W)
Location as "NE/CNW/SW" or footage from lines S $\frac{1}{2}$ S $\frac{1}{2}$ SW $\frac{1}{4}$
Lease Owner Petroleum Management, Inc. For Don H. Wells
Lease Name Slansky "A" Well No. 2
Office Address 810 Central Building - Wichita, Kansas
Character of Well (completed as Oil, Gas or Dry Hole) _____
Date well completed _____ 19____
Application for plugging filed _____ 19____
Application for plugging approved _____ 19____
Plugging commenced _____ November 2 1955
Plugging completed _____ November 6 1955
Reason for abandonment of well or producing formation _____

If a producing well is abandoned, date of last production _____ 19____
Was permission obtained from the Conservation Division or its agents before plugging was commenced? Yes

Name of Conservation Agent who supervised plugging of this well Eldon Petty
Producing formation _____ Depth to top _____ Bottom _____ Total Depth of Well 3440 Feet
Show depth and thickness of all water, oil and gas formations.

OIL, GAS OR WATER RECORDS

CASING RECORD

FORMATION	CONTENT	FROM	TO	SIZE	PUT IN	PULLED OUT
				5-1/2"	3427'	2733'
				8-5/8"	180'	None
				Lane Wells plug set at 3130' and casing perforated from 3107' to 3112'.		

Describe in detail the manner in which the well was plugged, indicating where the mud fluid was placed and the method or methods used in introducing it into the hole. If cement or other plugs were used, state the character of same and depth placed, from _____ feet to _____ feet for each plug set.

Filled the hole with sand from 3130' to 3096' and ran 6 sacks of cement. Pumped in 30 sacks of mud and 60 sacks of cement to surface pipe to fill to base of cellar. Plugging compltd.

Name of Plugging Contractor West Supply Co., Inc. (If additional description is necessary, use BACK of this sheet)
Address Chase, Kansas

STATE OF _____, COUNTY OF _____, SS. _____ (employee of owner) or (owner or operator) of the above-described well, being first duly sworn on oath, says: That I have knowledge of the facts, statements, and matters herein contained and the log of the above-described well as filed and that the same are true and correct. So help me God.

(Signature) John W. Pritchard
810 Central Bldg. (Address)

SUBSCRIBED AND SWORN TO before me this 15th day of November, 1955

My commission expires April 23, 1958

Massie C. Murphy
Notary Public.

RECEIVED
STATE CORPORATION COMMISSION

DEC 2 - 1955 12-2-55

CONSERVATION DIVISION
Wichita, Kansas

PLUGGING
FILE SEC. 35 T. 8 R. 19W
BOOK PAGE 13 LINE 14

WELL LOG BUREAU—KANSAS GEOLOGICAL SOCIETY

508 East Murdock,

Wichita, Kansas


15-163-02998-00-00

Company- STRAIN DRIG. CO.
Farm- Slansky "A" No. 2

SEC. 35 T. 8 R. 19W
S/2 S/2 SW

Total Depth. 3440 R.B.
Comm. 10-11-51 Comp. 10-23-51
Shot or Treated.
Contractor.
Issued. 12-22-51

County Rooks
KANSAS

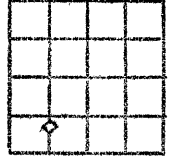

Elevation. 1983 DF

Production. 39 bbls.

CASING:

8 5/8" 182' cem. w/100 sx
5 1/2" 3427' cem. w/100 sx

Figures Indicate Bottom of Formations.

no record	185
shale & shells	300
shale	975
sand	1115
red bed	1190
red bed & shale	1390
anhydrite	1425
shale & shells	2000
shale & lime	2320
no record	2445
shale & lime	3091
lime	3430
arbuckle	3440
Total Depth R.B.	

Tops:
Anhydrite 1390
Topeka 2926
Heebner 3136
Tronto 3161
Lansing 3174
Arbuckle 3425

DST: 3234'-3272' tool open
1 hr. strong blow seven min.
weak blow 40 mins. rec. 115'
rotary mud. S. I. 15 min.
BHP 830#.

DST: 3340'-3386' tool open 1
hr. weak blow throughout rec.
54' moderately heavy oil cut
mud. S.I. 15 min. Pressure
recorder failed to operate only
one pressurere bomb was used.

DST: 3427-3432' tool open 30
min. weak blow 4 min. rec. 5'
drlg. mud I.S. 15 min. no BHP.

DST: 3427-3440' tool open 1 hr.
weak blow throughout; rec. 60'
oil cut mud S.I. 15 min.; BHP 380#.

12-2-55

RECEIVED
THE COMMISSION

DEC 2 1955

CONSERVATION DIVISION
Wichita, Kansas

RECEIVED

NOV 16 1955

PETROLEUM MANAGEMENT, INC.

PLUGGING

FILE SEC. 35 T. 8 R. 19W
BOOK PAGE 13 LINE 14