

15-163-00143-00-00

WELL PLUGGING RECORD


OR

FORMATION PLUGGING RECORD

Strike out upper line when reporting plugging of formations.

STATE OF KANSAS STATE CORPORATION COMMISSION Give All Information Completely Make Required Affidavit Mail or Deliver Report to: Conservation Division State Corporation Commission 800 Bitting Building Wichita, Kansas

Rocks _____ County. Sec. 36 Twp. 8S Rge. (E) 19 (W) Location as "NE1/4NW1/4SW1/4" or footage from lines NW SW SW Lease Owner Cardinal Oil Company, et al (Jackson Drlg & Westgate) Lease Name Slansky Well No. 1 Office Address 1022 Union National Bank Bldg, Wichita 2, Kansas Character of Well (completed as Oil, Gas or Dry Hole) dry hole Date well completed November 13, 1948 Application for plugging filed November 13, 1948 Application for plugging approved November 13, 1948 Plugging commenced November 13, 1948 Plugging completed November 13, 1948 Reason for abandonment of well or producing formation dry hole

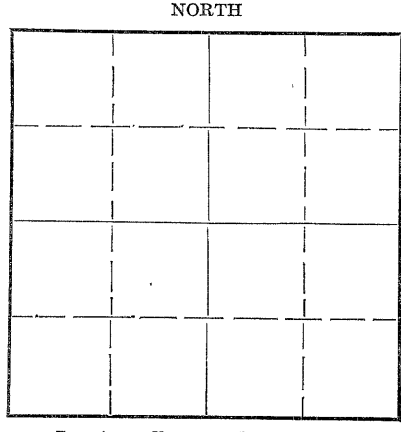

Locate well correctly on above Section Plat

If a producing well is abandoned, date of last production _____ 19 _____ Was permission obtained from the Conservation Division or its agents before plugging was commenced? yes

Name of Conservation Agent who supervised plugging of this well M. A. Rives Producing formation _____ Depth to top _____ Bottom _____ Total Depth of Well _____ Feet Show depth and thickness of all water, oil and gas formations.

OIL, GAS OR WATER RECORDS

CASING RECORD

Table with 7 columns: Formation, Content, From, To, Size, Put In, Pulled Out. Row 1: surface, 0, 154, 10 3/4", 154, none.

Describe in detail the manner in which the well was plugged, indicating where the mud fluid was placed and the method or methods used in introducing it into the hole. If cement or other plugs were used, state the character of same and depth placed, from _____ feet to _____ feet for each plug set.

Filled hole with heavy mud from 3470 to 154 feet Halliburton plug at 154 feet with 20 sacks cement run Filled to 20 feet with heavy mud and set Halliburton plug at 20 feet and run 10 sacks cement filled to cellar base

RECEIVED Conservation Div. DEC - 2 1948 STATE CORPORATION COMMISSION KANSAS

12-2-48

(If additional description is necessary, use BACK of this sheet) Correspondence regarding this well should be addressed to G. E. Bitler, Westgate-Greenland Oil Company Address 1022 Union National Bank Building, Wichita 2, Kansas

STATE OF Kansas, COUNTY OF Sedgwick, ss. G. E. Bitler (employee of owner) or (owner or operator) of the above-described well,

being first duly sworn on oath, says: That I have knowledge of the facts, statements, and matters herein contained and the log of the above-described well as filed and that the same are true and correct. So help me God.

(Signature) G. E. Bitler

1022 Union National Bank Building, Wichita 2, Ks (Address)

SUBSCRIBED AND SWORN to before me this 1st day of December, 1948

Esther Russell

Notary Public.

My commission expires May 25, 1948

PLUGGING 22-2625 2-48-15M FILE SEC 36 T 8 R 19 W BOOK PAGE 68 LINE 18

COMPANY: Cardinal Oil Company, et al
 (Jackson Drilling Corp., Westgate Greenland Oil Co)

CONTRACTOR: Jackson Drilling Corporation

FARM: Slansky #1

LOCATION: NW SW SW Section 36-88-19W
 Rooks County, Kansas

ELEVATION: 1971

COMMENCED: October 31, 1948

COMPLETED: November 13, 1948

0	to	165	Shale & shells
165	to	335	Shale
335	to	345	Shells
345	to	425	Sand
425	to	890	Shale & shells
890	to	1100	Sand
1100	to	1115	Sand Shale
1115	to	1281	Shale & shells
1281	to	1335	Shale & shells
1335	to	1390	Shells
1390	to	1430	Shale
1430	to	1630	Shale & shells
1630	to	1825	Shale
1825	to	1930	Shale Chert
1930	to	1963	Shale & lime
1963	to	1985	Lime
1985	to	2165	Lime & shale
2165	to	2190	Shale
2190	to	2235	Shale
2235	to	2265	Lime
2265	to	2390	Shale & shells
2390	to	2445	Lime & shale
2445	to	2610	Lime
2610	to	2685	Lime & shale
2685	to	2980	Shale
2980	to	3058	Lime
3058	to	3150	Lime & shale
3150	to	3470	Lime
		3470 T. D.	

11-23-48

Ran 154 feet - 10 3/4" surface casing. Cemented with 100 sacks cement.

Top Arbuckle 3436

Dry and Abandoned


CERTIFICATE

I, Clare A. Stewart, do hereby certify that the above and foregoing is a true and correct copy of log of the Slansky #1, Section 36-88-19W, Rooks County, Kansas, as reflected by files of the Jackson Drilling Corporation.

Clare A. Stewart
Clare A. Stewart

Subscribed and sworn to before me, a Notary Public, within and for Johnson County, Kansas, this 19th day of November, 1948

Dorothy J. Wilson
Dorothy J. Wilson

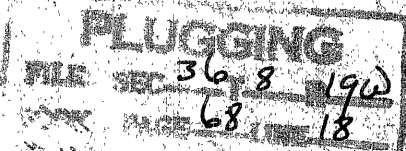

My Commission expires November 30, 1950