


STATE OF KANSAS  
STATE CORPORATION COMMISSION

Give All Information Completely  
Make Required Affidavit  
Mail or Deliver Report to:  
Conservation Division  
State Corporation Commission  
800 Bitting Building  
Wichita, Kansas

15-163-00607-00-00

WELL PLUGGING RECORD

NORTH

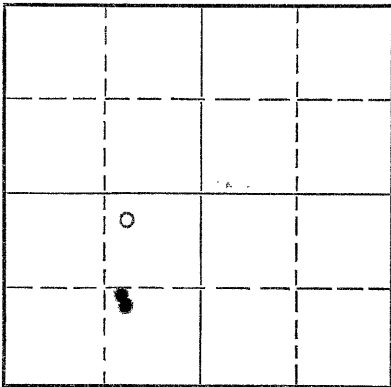

Locate well correctly on above  
Section Plat

Rooks County. Sec. 36 Twp. 8 Rge. 19 ~~(W)~~ W (W)  
Location as "NE/CNW/SW" or footage from lines NW NE SW  
Lease Owner Nadel and Gussman  
Lease Name Slansky Well No. 1  
Office Address P. O. Box 309, Tulsa, Oklahoma  
Character of Well (completed as Oil, Gas or Dry Hole) Dry  
Date well completed 9-3-1954  
Application for plugging filed 9-3-1954  
Application for plugging approved 9-3-1954  
Plugging commenced 9-3-1954  
Plugging completed 9-3-1954  
Reason for abandonment of well or producing formation Dry

If a producing well is abandoned, date of last production \_\_\_\_\_ 19\_\_\_\_  
Was permission obtained from the Conservation Division or its agents before plugging was commenced? Yes

Name of Conservation Agent who supervised plugging of this well Eldon Petty  
Producing formation \_\_\_\_\_ Depth to top \_\_\_\_\_ Bottom \_\_\_\_\_ Total Depth of Well 3500 Feet  
Show depth and thickness of all water, oil and gas formations.

OIL, GAS OR WATER RECORDS

CASING RECORD

FORMATION	CONTENT	FROM	TO	SIZE	PUT IN	PULLED OUT
				8-5/8	190	0

Describe in detail the manner in which the well was plugged, indicating where the mud fluid was placed and the method or methods used in introducing it into the hole. If cement or other plugs were used, state the character of same and depth placed, from \_\_\_\_\_ feet to \_\_\_\_\_ feet for each plug set.

Filled hole with heavy mud from T.D. to 190' - set plug and cemented with 15 sacks cement, filled to 40' with mud - set plug and cemented to top of surface pipe.

(If additional description is necessary, use BACK of this sheet)  
Name of Plugging Contractor Reserve Drilling Company, Inc.  
Address 703 Union National Bank Bldg. Wichita 2, Kansas

STATE OF KANSAS, COUNTY OF SEDGWICK, ss.  
L. C. Hay (employee of owner) of (owner or operator) of the above-described well, being first duly sworn on oath, says: That I have knowledge of the facts, statements, and matters herein contained and the log of the above-described well as filed and that the same are true and correct. So help me God.

(Signature) L. C. Hay

SUBSCRIBED AND SWORN TO before me this 8th day of September, 1954

My commission expires Nov. 3, 1956 Rola Bass Notary Public.

24-7368-5 3-53-20M

PLUGGING  
FILE SEC 36 T 8 R 19  
BOOK PAGE 61 LINE 42

15-163-00667-00-00

WELL LOG

RADEL AND GUSMAN

SLANSKY WELL No. 1

NW NE SW 36-8-19W  
Rooks County, Kansas

Comm: 8-24-54  
Comp: 9- 3-54

Casing: 8-5/8" 190' w/115 sax

Formations

Depths

Shale  
Shale and red bed  
Shale and shells  
Shells and lime  
Lime and shale  
Lime  
Lime and shale  
Lime  
Lime and shale  
Shale Conglomerate  
Chert Conglomerate

1450  
1670  
1935  
2055  
3138  
3215  
3245  
3428  
3461  
3470  
3500

GEOLOGICAL TOPS

Heebner Shale 3181  
Toronto Lime 3204  
Lansing-Kansas City 3220  
Shaley Conglomerate 3461  
Cherty Conglomerate 3470

STATE OF KANSAS

COUNTY OF SEDGWICK

} SS:

L. C. Hay, of lawful age, deposes and states that the above formations and depths are correct as shown by the daily drilling log of the Slansky No. 1 in the NW NE SW 36-8-19W, Rooks County, Kansas.

L. C. Hay

Subscribed and sworn to before me this 8th day of September, 1954.

Roll Papp  
Notary Public

My commission expires Nov. 3, 1956

**PLUGGING**  
PAGE SEC 36 T 8 R 19W  
BOOK PAGE 61 LINE 42

9-16-54