

15-163-02539-00-60
WELL PLUGGING RECORD

STATE OF KANSAS
STATE CORPORATION COMMISSION


Give All Information Completely
Make Required Affidavit
Mail or Deliver Report to:
Conservation Division
State Corporation Commission
800 Biting Building
Wichita, Kansas

OR
FORMATION PLUGGING RECORD

Strike out upper line
when reporting plug-
ging off formations.

Rooks County. Sec. 2 Twp. 8S, Rge. (E) 20 (W)

Location as "NE 1/4 NW 1/4 SW 1/4" or footage from lines CNE 1/4 NE 1/4
Lease Owner National Associated Petroleum Co.
Lease Name Hugley Well No. 1
Office Address 428 RITZ BUILDING - TULSA 3, OKLAHOMA
Character of Well (completed as Oil, Gas or Dry Hole) DRY HOLE.
Date well completed OCTOBER 22 19 43
Application for plugging filed OCTOBER 14 19 43
Application for plugging approved OCTOBER 14 19 43
Plugging commenced OCTOBER 17 19 43
Plugging completed OCTOBER 22 19 43
Reason for abandonment of well or producing formation DRY HOLE.

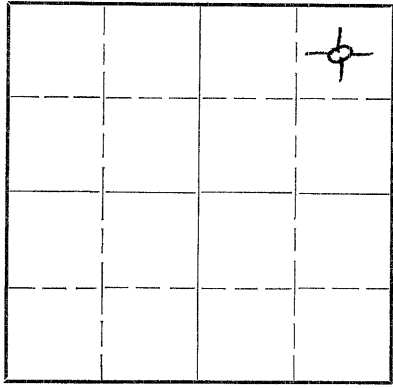

Locate well correctly on above
Section Plat

If a producing well is abandoned, date of last production NONE. 19
Was permission obtained from the Conservation Division or its agents before plugging was com-
menced? YES -

Name of Conservation Agent who supervised plugging of this well ALEXANDER
Producing formation _____ Depth to top _____ Bottom _____ Total Depth of Well 3444 Feet
Show depth and thickness of all water, oil and gas formations.

OIL, GAS OR WATER RECORDS


CASING RECORD

Formation	Content	From	To	Size	Put In	Pulled Out
		<u>SURFACE</u>	<u>1438'</u>	<u>8 5/8"</u>	<u>1438'</u>	<u>NONE.</u>
				<u>5 1/2"</u>	<u>3408</u>	<u>2601'</u>

Describe in detail the manner in which the well was plugged, indicating where the mud fluid was placed and the method or methods used in introducing it into the hold. If cement or other plugs were used, state the character of same and depth placed, from _____ feet to _____ feet for each plug set.

Oct. 18 mudded up from 3082 to 3010 set bridge
dumped 4 bar cement for plug at 2974
" 19 shot pipe at 2750, 2650 and 2550
" 20 mudded from 2974 to 1600.
" 22 " " 1600 to 300 set bridge dumped
7 bar cement up to 25 ft. Dumped 7 bar cement.

PLUGGING
OCT 22 8 20 W
WELL LOG 95 LINE 27

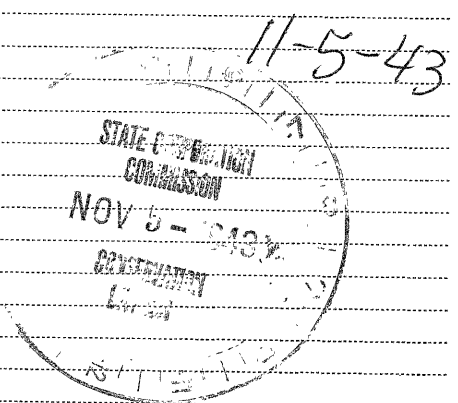

(If additional description is necessary, use BACK of this sheet)

Correspondence regarding this well should be addressed to NATIONAL ASSOCIATED PETROLEUM CO.
Address 428 RITZ BUILDING
TULSA 3, OKLAHOMA.

STATE OF OKLAHOMA. COUNTY OF TULSA. SS.
J. A. KIEDAISCH (employee of owner) or (owner or operator) of the above-described well,
being first duly sworn on oath, says: That I have knowledge of the facts, statements, and matters herein contained and the log of the above-
described well as filed and that the same are true and correct. So help me God.

(Signature) J. A. Kiedaisch
428 RITZ BLD - TULSA 3, OKLA. (Address)

SUBSCRIBED AND SWORN to before me this 4th day of November, 19 43
Samuel Eaton Notary Public.

My commission expires Nov. 18, 1944