


Give All Information Completely
Make Required Affidavit
Mail or Deliver Report to:
Conservation Division
State Corporation Commission
800 Bittling Building
Wichita, Kansas

OR
FORMATION PLUGGING RECORD

Strike out upper line
when reporting plug-
ging off formations.

NORTH

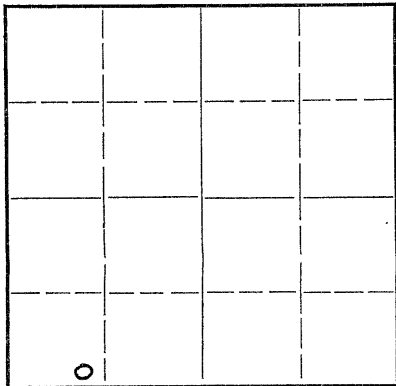

Locate well correctly on above
Section Plat

Rooks _____ County, Sec. 5 Twp. 8S Rge. 20W (E) _____ (W) _____
Location as "NE $\frac{1}{4}$ NW $\frac{1}{4}$ SW $\frac{1}{4}$ " or footage from lines SE $\frac{1}{2}$ SW $\frac{1}{2}$ SW $\frac{1}{2}$
Continental Oil Co.
Lease Owner _____
Lease Name Triplett Well No. 1
Office Address Ponca City, Oklahoma
Character of Well (completed as Oil, Gas or Dry Hole) Stratigraphic Test
Date well completed Dec. 18, 19 42
Application for plugging filed Dec. 18, 19 42
Application for plugging approved Dec. 18, 19 42
Plugging commenced Dec. 18, 19 42
Plugging completed Dec. 19, 19 42
Reason for abandonment of well or producing formation _____

If a producing well is abandoned, date of last production _____ 19 _____
Was permission obtained from the Conservation Division or its agents before plugging was com-
menced? Yes

Name of Conservation Agent who supervised plugging of this well C. T. Alexander
Producing formation _____ Depth to top _____ Bottom _____ Total Depth of Well 3505 Feet
Show depth and thickness of all water, oil and gas formations.


OIL, GAS OR WATER RECORDS

CASING RECORD

Formation	Content	From	To	Size	Put In	Pulled Out
				8 5/8 in	84 ft.	none

Describe in detail the manner in which the well was plugged, indicating where the mud fluid was placed and the method or methods used in introducing it into the hold. If cement or other plugs were used, state the character of same and depth placed, from _____ feet to _____ feet for each plug set.

The hole was filled with heavy mud by circulating every 500 ft. A bridge was set at 250 ft. and cemented with 15 sacks of cement put in thru the drill pipe. The hole was then filled with heavy mud to 26 feet where another bridge was set and the hole filled to the top of the casing with cement.

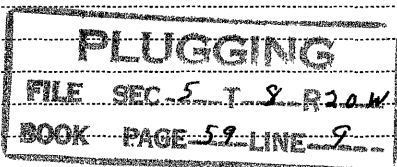

12-30-42

(If additional description is necessary, use BACK of this sheet)
Correspondence regarding this well should be addressed to J. George Klein
Address Box 6 Plainville, Kansas

STATE OF Kansas, COUNTY OF Rooks, ss.
J. George Klein (employee of owner) ~~or (owner or operator)~~ of the above-described well,
being first duly sworn on oath, says: That I have knowledge of the facts, statements, and matters herein contained and the log of the above-described well as filed and that the same are true and correct. So help me God.

(Signature) J. George Klein
Plainville, Kans. (Address)

SUBSCRIBED AND SWORN to before me this 29th day of December, 1942
Georgia Reed Notary Public.

My commission expires March 6, 1944