


STATE OF KANSAS
STATE CORPORATION COMMISSION

15-163-00208-00-00
WELL PLUGGING RECORD

Give All Information Completely
Make Required Affidavit
Mail or Deliver Report to:
Conservation Division
State Corporation Commission
809 Bittling Building
Wichita, Kansas

Rooks County, Sec. 6 Twp. 8S Rge. 20 (W)

Location as "NE/CNW $\frac{1}{4}$ SW $\frac{1}{4}$ " or footage from lines SW $\frac{1}{4}$ SW $\frac{1}{4}$ SW $\frac{1}{4}$
Lease Owner Heatman-Honaker Drilling Co., Inc., et al
Lease Name L. THYFAULT Well No. 1
Office Address 509-510 Orpheum Bldg., Wichita, Kansas
Character of Well (completed as Oil, Gas or Dry Hole) dry hole
Date well completed 6-11-1949
Application for plugging filed 6-11-1949
Application for plugging approved 6-11-1949
Plugging commenced 6-11-1949
Plugging completed 6-11-1949
Reason for abandonment of well or producing formation

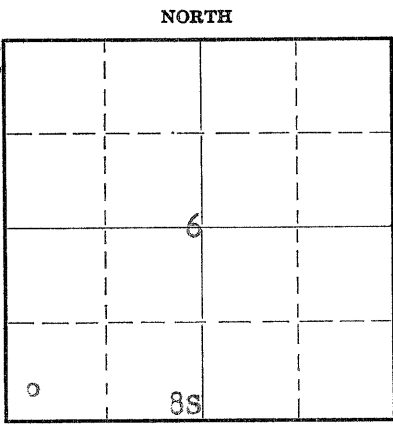

Locate well correctly on above Section Plat

If a producing well is abandoned, date of last production 19
Was permission obtained from the Conservation Division or its agents before plugging was commenced? yes

Name of Conservation Agent who supervised plugging of this well C. D. Stough
Producing formation none Depth to top Bottom Total Depth of Well 3591 Feet
Show depth and thickness of all water, oil and gas formations.

OIL, GAS OR WATER RECORDS

CASING RECORD

| Formation | Content | From | To | Size | Put In | Pulled Out |
|-----------|---------|------|----|----------------|---------|------------|
| none | none | | | 8-5/8" surface | 166.56' | none |
| | | | | | | |
| | | | | | | |
| | | | | | | |
| | | | | | | |

Describe in detail the manner in which the well was plugged, indicating where the mud fluid was placed and the method or methods used in introducing it into the hole. If cement or other plugs were used, state the character of same and depth placed, from feet to feet for each plug set.

Filled hole with heavy mud, then set bottom plug @ 160' w/15 sacks cement;
Filled hole up mud to top plug 30' down; set top plug, cemented with 10 sacks to top of surface; surface pipe cut off 2' below level of ground.

RECORDED
JUN 15 1949
STATE CORPORATION COMMISSION
WICHITA, KANSAS
6/15/49

(If additional description is necessary, use BACK of this sheet)

Correspondence regarding this well should be addressed to Heathman-Honaker Drilling Co., Inc.
Address 509 Orpheum Bldg., Wichita, Kansas


STATE OF Kansas, COUNTY OF Sedgwick, ss.
H. D. Shreve (employee of owner or (owner or operator) of the above-described well,
being first duly sworn on oath, says: That I have knowledge of the facts, statements, and matters herein contained and the log of the above-described well as filed and that the same are true and correct. So help me God. HEATHMAN-HONAKER DRILLING CO., INC.

(Signature) BY: H. D. Shreve
509 Orpheum Bldg., Wichita, Kansas
(Address)

SUBSCRIBED AND SWORN TO before me this 14th day of June, 1949

My commission expires June 28, 1952.

10. Marjorie M. Met Notary Public.

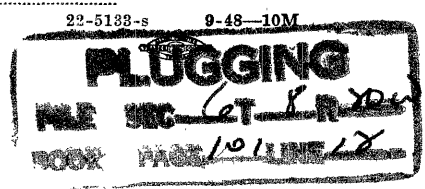

L. THYFAULT # 1 WELL

Location: Approx. Ctr. SW/4 SW/4 SW/4 Sec. 6-8S-20W Rooks County, Kansas Date Spudded: 6-2-49
 Operator: Heathman-Honaker Drilling Co., Inc. Date rotary completion: 6-11-49
 Contractor: Heathman-Honaker Drilling Co., Inc. Elevation: 1981 DF 1983 KB
 Surface Pipe: 5 jts. (166.56') 8-5/8" cemented @ 162.56' w/125 sacks and 1 CC Total Depth: 3591'
 Oil String: None run
 Dry and abandoned - plugged - 6-11-49

T O P S (KB)

| | |
|--------------|--------------|
| Anhydrite | 1551 (+ 432) |
| Heebner | 3167 (-1184) |
| Lansing-K.C. | 3206 (-1223) |
| Base K.C. | 3416 (-1433) |
| Conglomerate | 3452 (-1469) |
| Total Depth | 3591 (-1608) |

L O G

(Figures indicate bottom of formation)

| | |
|------------------------|----------|
| Sand and shale | 0 to 165 |
| Shale, shells and sand | 1266 |
| Shale shells | 1551 |
| Anhydrite | 1592 |
| Shale shells | 1987 |
| Shale lime | 3114 |
| Shale | 3445 |
| Lime and shale | 3452 |
| Congl. Chert | 3470 |
| Chert | 3489 |
| Lime and shale | 3501 |
| Congl. and chert | 3518 |
| Shale | 3529 |
| Conglomerate | 3566 |
| Cherty Conglomerate | 3591 |
| Total Depth | 3591' |

RECEIVED
 JUN 15 1949
 STATE REGISTRATION
 COMMISSION
 KANSAS

6/15/49

The undersigned, H. D. SHREVE, of the Heathman-Honaker Drilling Co., Inc., hereby certifies that the above log is a true and correct log of the formations encountered in drilling the above noted well as reflected by the Daily Drilling Reports.

HEATHMAN-HONAKER DRILLING CO., INC.
 BY: H. D. Shreve
 H. D. Shreve

Subscribed and sworn to before me this 14th day of June, 1949.

R. D. Marjorie Mott
 Notary Public

My commission expires: June 28, 1952.

PLUGGING
 FILE SEC 6 T 8 20W
 BOOK PAGE 101 LINE 18