

15-163-00362-0600

STATE OF KANSAS
STATE CORPORATION COMMISSION

WELL PLUGGING RECORD


Give All Information Completely
Make Required Affidavit
Mail or Deliver Report to:
Conservation Division
State Corporation Commission
800 Biting Building
Wichita, Kansas

Rooks

County. Sec. 9 Twp. 8 Rge. 20 (E) W (W)

Location as "NE/CNW $\frac{1}{4}$ SW $\frac{1}{4}$ " or footage from lines N/2 NE NE
Lease Owner B & R Drilling, Inc.
Lease Name Brown Well No. 1
Office Address Russell, Kansas
Character of Well (completed as Oil, Gas or Dry Hole) Dry Hole
Date well completed July 12, 1951
Application for plugging filed July 10, 1951 Verbally
Application for plugging approved July 10, 1951 "
Plugging commenced July 11, 1951
Plugging completed July 11, 1951
Reason for abandonment of well or producing formation Dry Hole

NORTH

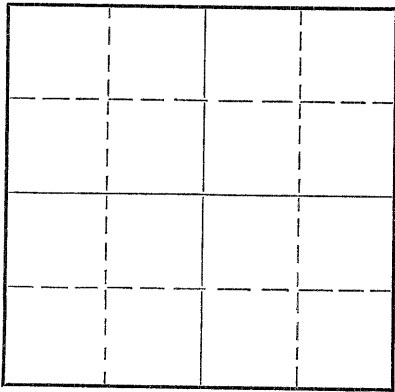

Locate well correctly on above
Section Plat

If a producing well is abandoned, date of last production 19...
Was permission obtained from the Conservation Division or its agents before plugging was com-
menced? Yes

Name of Conservation Agent who supervised plugging of this well Eldon Petty
Producing formation Depth to top Bottom Total Depth of Well 3460' Feet
Show depth and thickness of all water, oil and gas formations.

OIL, GAS OR WATER RECORDS

CASING RECORD

Formation	Content	From	To	Size	Put In	Pulled Out
				8 5/8"	1487'	None

Describe in detail the manner in which the well was plugged, indicating where the mud fluid was placed and the method or methods used in introducing it into the hole. If cement or other plugs were used, state the character of same and depth placed, from feet to feet for each plug set.

Plugging Record

Filled hole with heavy mud to 240'. Put plug at 240' and 15 sacks cement thru drill pipe. Filled hole with mud to 40' set plug. Put 1/2 Sacks Hulls in hole and 10 sacks cement.

(If additional description is necessary, use BACK of this sheet)

Correspondence regarding this well should be addressed to B & R Drilling, Inc.
Address Russell, Kansas

STATE OF Kansas, COUNTY OF Russell, ss.
W. A. Michaelis, Jr. (employee of owner) or (owner or operator) of the above-described well,


being first duly sworn on oath, says: That I have knowledge of the facts, statements, and matters herein contained and the log of the above-described well as filed and that the same are true and correct. So help me God.

(Signature) W. A. Michaelis, Jr.
Russell, Kansas (Address)

SUBSCRIBED AND SWORN to before me this 18th day of July, 1951

My commission expires 6-17-54

Notary Public. Clara Lamm

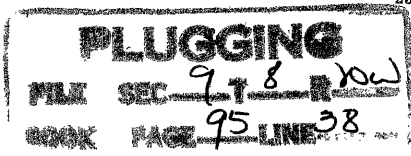

28-3278-s 4-50-10M

7-23-51

15-163-00362-00-00

B & R Drilling, Inc.
Brown No. 1

N/2 NE NE Sec. 9-8-20
Rooks County, Kansas

Total Depth: 3460'
Comm: 6-14-51
Comp: 7-12-51

Casing

Cement

8 5/8" Set @ 1487'

750 Sacks of Bulk

Formation	Depth
Sand	15
Shale-Shells	85
Sand-Shale	175
Shale-Shells	570
Shale-Sand	687
Shale-Sand-Pyrite	1090
Sand	1250
Shale-Shells	1344
Bedrock-Shells	1570
Shale-Shells	1580
Anhydrite	1603
Reamed Hole	
Shale-Sand	810
Shale-Sand-Pyrite	1028
Sand-Shells	1255
Shale-Redbed	1315
Redbed	1480
Anhydrite	1520
Shale-Shells	1915
Shale-Lime	3225
Lime	3390
Lime-Shale	3425
Arbuckle	3428
Lime	3460

STATE OF KANSAS)
)SS
RUSSELL COUNTY)

I hereby certify that the above information is true and correct to the best of my knowledge.

Violet Keller

Subscribed and sworn to before me this 18,th day of July, 1951

Clara Hammond
Notary Public

My commission expires: 6-17-54

RECEIVED
STATE CORPORATION COMMISSION
JUL 23 1951
CONSERVATION DIVISION
Wichita, Kansas

WIGGINS
9-18-51
95-38

9-23-51