

15163 21927-00-00

STATE OF KANSAS
STATE CORPORATION COMMISSION


WELL PLUGGING RECORD

Give All Information Completely
Make Required Affidavit
Mail or Deliver Report to
Conservation Division
State Corporation Comm.
245 North Water
Wichita, KS 67202

Rooks County. Sec. 12 Twp. 8S Rge. 20W E/W
Location as "NE/CNW $\frac{1}{4}$ SW $\frac{1}{4}$ " or footage from lines

E/2 NW SW
Lease Owner F & M OIL CO., INC.
Lease Name Gosselin "A" Well No. 1

Office Address 422 Union Center, Wichita, Ks. 67202
Character of Well (Completed as Oil, Gas or Dry Hole)
Dry Hole

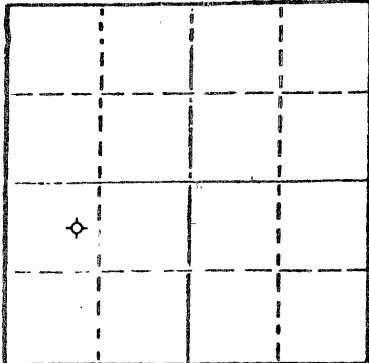

Locate well correctly on above
Section Plot

Date Well completed June 18, 1983
Application for plugging filed June 18, 1983
Application for plugging approved June 18, 1983
Plugging commenced June 18, 1983
Plugging completed June 18, 1983

Reason for abandonment of well or producing formation
Dry Hole
If a producing well is abandoned, date of last production
19

Was permission obtained from the Conservation Division or
its agents before plugging was commenced? Yes

Name of Conservation Agent who supervised plugging of this well Marion Schmidt
Producing formation _____ Depth to top _____ Bottom _____ Total Depth of Well 3520'
Show depth and thickness of all water, oil and gas formations.

OIL, GAS OR WATER RECORDS

CASING RECORD

FORMATION	CONTENT	FROM	TO	SIZE	PUT IN	PULLED OUT

Describe in detail the manner in which the well was plugged, indicating where the mud fluid
was placed and the method or methods used in introducing it into the hold. If cement or other
plugs were used, state the character of same and depth placed, from _____ feet to
_____ feet for each plug set.

- Set 1st plug @ 3500' w/38 sxs
- Set 2nd plug @ 1516' w/20 sxs
- Set 3rd plug @ 773' w/80 sxs
- Set 4th plug @ 302' w/40 sxs
- Set 5th plug @ 40' w/10 sxs
- 50/50 posmix, 4% gel, 3% CC, plug down @ 5:15 AM 6-18-83

(If additional description is necessary, use BACK of this sheet)

Name of Plugging Contractor Union Drilling Co., Inc.

STATE OF Kansas COUNTY OF Sedgwick, ss.
R. D. Messinger (employee of owner) or (owner or operator)

of the above-described well, being first duly sworn on oath, says: That I have knowledge of
the facts, statements, and matters herein contained and the log of the above-described well
as filed and that the same are true and correct. So help me God.

(Signature) R. D. Messinger
422 Union Center, Wichita, Ks. 67202
(Address)

SUBSCRIBED AND SWORN TO before me this 5th day of July, 1983

Shirley A. Gallegos
Notary Public.

My commission expires 12-24-84 Shirley A. Gallegos



RECEIVED
STATE CORPORATION COMMISSION

JUL 12 1983

7-12-83

CONSERVATION DIVISION
Wichita, Kansas

15-163-21927-00-00

CONTRACTOR'S WELL LOG

OPERATOR:	F & M OIL CO., INC.
CONTRACTOR:	Union Drilling Co., Inc.
LEASE NAME:	Gosselin "A" #1
LOCATION:	E/2 NW SW Section 12-8S-20W Rooks County, Kansas
COMMENCED:	June 09, 1983
COMPLETED:	June 18, 1983

0	1565	Shale	Set 8-5/8" @ 252' w/165 sxs common
1565	1787	Shale & Lime	cement 2% gel, 3% CC
1787	3520	Lime & Shale	
3520		RTD	

We certify that the above foregoing is a true and correct copy of the log on the Gosselin "A" #1, E/2 NW SW Section 12-8S-20W, Rooks County, Kansas.

Union Drilling Co., Inc.

R. D. Messinger

 R. D. Messinger

STATE OF KANSAS)
) SS
 COUNTY OF SEDGWICK)

Subscribed and sworn to before me, a Notary Public, in and for the aforesaid County and State as of this 7th day of July, 1983.

My appointment expires:

12-24-84

Shirley A. Gallegos

 Shirley A. Gallegos-Notary Public



RECEIVED
 STATE CORPORATION COMMISSION

JUL 12 1983

7-12-83
 CONSERVATION DIVISION
 Wichita, Kansas