

15-143-21825-00-00

STATE OF KANSAS
STATE CORPORATION COMMISSION

WELL PLUGGING RECORD

Give All Information Completely
Make Required Affidavit
Mail or Deliver Report to
Conservation Division
State Corporation Comm.
245 North Water
Wichita, KS 67202

Rooks County, Sec. 13 Twp. 8S Rge. 20W E/W
Location as "NE/CNW $\frac{1}{4}$ SW $\frac{1}{4}$ " or footage from lines
SE SE NW

Lease Owner F & M OIL CO., INC.

Lease Name Roy Well No. 2

Office Address 422 Union Center, Wichita, Ks. 67202

Character of Well (Completed as Oil, Gas or Dry Hole)
Dry Hole

Date Well completed October 29, 1982

Application for plugging filed October 29, 1982

Application for plugging approved October 29, 1982

Plugging commenced October 29, 1982

Plugging completed October 29, 1982

Reason for abandonment of well or producing formation
Dry


If a producing well is abandoned, date of last production
19

Was permission obtained from the Conservation Division or
its agents before plugging was commenced? Yes

Name of Conservation Agent who supervised plugging of this well Marion Schmidt

Producing formation Depth to top Bottom Total Depth of Well 3525'

Show depth and thickness of all water, oil and gas formations.

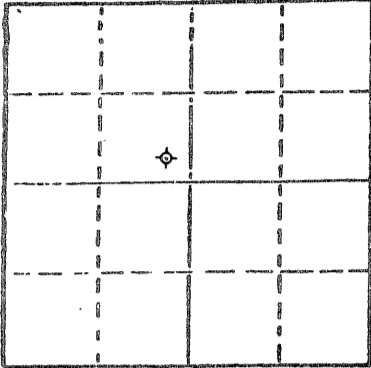

Locate well correctly on above
Section Plot

OIL, GAS OR WATER RECORDS

CASING RECORD

FORMATION	CONTENT	FROM	TO	SIZE	PUT IN	PULLED OUT

Describe in detail the manner in which the well was plugged, indicating where the mud fluid was placed and the method or methods used in introducing it into the hold. If cement or other plugs were used, state the character of same and depth placed, from feet to feet for each plug set.

- Set 1st plug @ 3480' w/20 sxs
- Set 2nd plug @ 1530' w/20 sxs
- Set 3rd plug @ 870' w/100 sxs
- Set 4th plug @ 270' w/40 sxs
- Set 5th plug @ 40' w/10 sxs
- 10 sxs in the rat hole, 200 sxs total used,
- 6% gel, 3% CC plug down @ 3:30 PM (10-29-82)

(If additional description is necessary, use BACK of this sheet)

Name of Plugging Contractor Union Drilling Co., Inc.

STATE OF Kansas COUNTY OF Sedgwick, ss.
R. D. Messinger (employee of owner) or (owner or operator)
of the above-described well, being first duly sworn on oath, says: That I have knowledge of the facts, statements, and matters herein contained and the log of the above-described well as filed and that the same are true and correct. So help me God.

(Signature) R. D. Messinger
422 Union Center, Wichita, Ks. 67202
(Address)

SUBSCRIBED AND SWORN TO before me this 11th day of November, 19 82

Shirley A. Gallegos
Shirley A. Gallegos Notary Public.

My commission expires 12-24-84

RECEIVED
STATE CORPORATION COMMISSION
NOV 12 1982
CONSERVATION DIVISION
Wichita, Kansas

15-163-21825-00-00

CONTRACTOR'S WELL LOG

OPERATOR: F & M OIL CO., INC.
 CONTRACTOR: Union Drilling Co., Inc.
 LEASE NAME: Roy #2
 LOCATION: SE SE NW Section 13-8S-20W
 Rooks County, Kansas
 COMMENCED: October 21, 1982
 COMPLETED: October 29, 1982

0	2010	Shale	Set 8-5/8" @ 253' w/common cement
2010	3525	Lime & Shale	2% gel, 3% CC
3525		RTD	

We certify that the above foregoing is a true and correct copy of the log on the Roy #2, SE SE NW Section 13-8S-20W, Rooks County, Kansas.

Union Drilling Co., Inc.



 R. D. Messinger

STATE OF KANSAS)
) SS
 COUNTY OF SEDGWICK)

Subscribed and sworn to before me, a Notary Public in and for the aforesaid County and State as of this 11th day of November, 1982.

My appointment expires:

12-24-84


 Shirley A. Gallegos-Notary Public