


15-163-02443-00-00

STATE OF KANSAS  
STATE CORPORATION COMMISSION

WELL PLUGGING RECORD

Give All Information Completely  
Make Required Affidavit  
Mail or Deliver Report to:  
Conservation Division  
State Corporation Commission  
800 Bitting Building  
Wichita, Kansas

NORTH

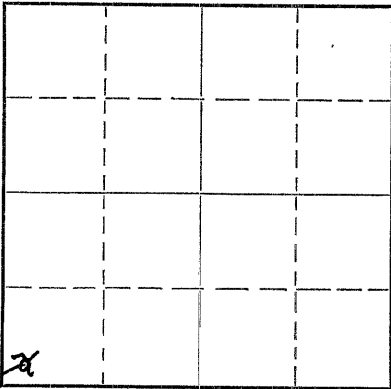

Locate well correctly on above  
Section Plat

Rocks \_\_\_\_\_ County. Sec. 16 Twp. 8 Rge. 20(E) W (W)  
Location as "NE/CNW $\frac{1}{4}$ SW $\frac{1}{4}$ " or footage from lines SW SW SW  
Lease Owner DEEP ROCK OIL CORPORATION  
Lease Name Burton Well No. 1  
Office Address Box #1051, Tulsa, Oklahoma  
Character of Well (completed as Oil, Gas or Dry Hole) Dry Hole  
Date well completed July 4 19 51  
Application for plugging filed July 16 19 51  
Application for plugging approved July 9 19 51  
Plugging commenced July 4 19 51  
Plugging completed July 5 19 51  
Reason for abandonment of well or producing formation \_\_\_\_\_

If a producing well is abandoned, date of last production \_\_\_\_\_ 19 \_\_\_\_  
Was permission obtained from the Conservation Division or its agents before plugging was commenced? Yes, permission was obtained by telephone from Mr. Petty.

Name of Conservation Agent who supervised plugging of this well Mr. Eldon Petty  
Producing formation Arbuckle Depth to top 3548' Bottom 3590' Total Depth of Well 3590' Feet  
Show depth and thickness of all water, oil and gas formations.

OIL, GAS OR WATER RECORDS

CASING RECORD

Formation	Content	From	To	Size	Put In	Pulled Out
				<u>8-5/8"</u>	<u>224'</u>	<u>None</u>

Describe in detail the manner in which the well was plugged, indicating where the mud fluid was placed and the method or methods used in introducing it into the hole. If cement or other plugs were used, state the character of same and depth placed, from \_\_\_\_\_ feet to \_\_\_\_\_ feet for each plug set.

Filled hole with heavy mud from 3590' up to 240'. Set bridge at 240' and put in 75 sacks cement and 100# calcium chloride. Put in heavy mud from 83' to 40'. Set 15' rock bridge at 40' and put in 18 sacks cement, filled to top of hole and into cellar.

(If additional description is necessary, use BACK of this sheet)

Correspondence regarding this well should be addressed to Deep Rock Oil Corporation  
Address Box #429, Hutchinson, Kansas

STATE OF Kansas, COUNTY OF Reno, ss. Jack Smith

(employee of owner) or (~~owner or operator~~) of the above-described well, being first duly sworn on oath, says: That I have knowledge of the facts, statements, and matters herein contained and the log of the above-described well as filed and that the same are true and correct. So help me God.

(Signature) Jack Smith

Box #429, Hutchinson, Kansas  
(Address)

SUBSCRIBED AND SWORN TO before me this 16<sup>th</sup> day of July, 1951

My commission expires My Commission Expires August 2, 1955 \_\_\_\_\_ Notary Public.

PLUGGING  
FILE REC 16 8 202  
BOOK PAGE 93 LINE 1

23-3273-s 4-50-10M

JUL 17 1951

7-17-51

Burton Well No. 1  
 Section 16-8S-20W  
 Rooks County, Kansas

Surface Clay and Sand	00'	200'
Shale	200'	620'
Sand	620'	685'
Shale	685'	1170'
Shale and Sand	1170'	1568'
Anhydrite	1568'	1600'
Shale	1600'	1966'
Shale and Lime	1966'	2540'
Broken Lime	2540'	2690'
Shale and Lime	2690'	3245'
Lime	3245'	3415'
Lime and Shale	3415'	3580'
Lime	3580'	3590'
Total Depth		3590'

16 8 20W  
 93 1

RECEIVED  
 COMMISSION  
 JUL 17 1951  
 REGISTRATION DIVISION  
 Wichita, Kansas