


STATE OF KANSAS
STATE CORPORATION COMMISSION

15-163-00329-00-00

WELL PLUGGING RECORD

Give All Information Completely
Make Required Affidavit
Mail or Deliver Report to:
Conservation Division
State Corporation Commission
800 Bitting Building
Wichita, Kansas

Rocks County. Sec. 20 Twp 8S Rge. 20 (25) W. (W)
Location as "NE/CNW $\frac{1}{4}$ SW $\frac{1}{4}$ " or footage from lines NW NW NW
Lease Owner DEEP ROCK OIL CORPORATION
Lease Name Normandin Well No. 1
Office Address Box #1051, Tulsa, Oklahoma
Character of Well (completed as Oil, Gas or Dry Hole) Dry Hole
Date well completed June 21 19 51
Application for plugging filed June 28 19 51
Application for plugging approved June 25 19 51
Plugging commenced June 22 19 51
Plugging completed June 22 19 51
Reason for abandonment of well or producing formation Dry Hole

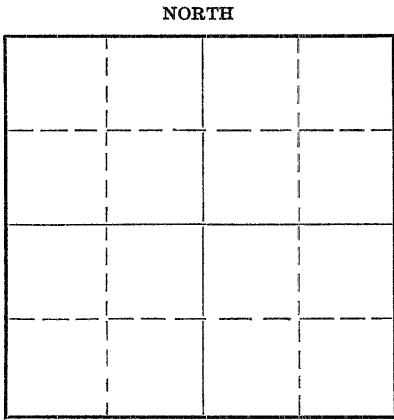

Locate well correctly on above Section Plat

If a producing well is abandoned, date of last production 19

Was permission obtained from the Conservation Division or its agents before plugging was commenced? Yes, permission obtained by telephone from Mr. Petty.

Name of Conservation Agent who supervised plugging of this well Mr. Eldon Petty
Producing formation Arbuckle Depth to top. 3648' Bottom. 3700' Total Depth of Well. 3700' Feet
Show depth and thickness of all water, oil and gas formations.

OIL, GAS OR WATER RECORDS

CASING RECORD

Formation	Content	From	To	Size	Put In	Pulled Out
				<u>8 5/8"</u>	<u>216'</u>	<u>None</u>

Describe in detail the manner in which the well was plugged, indicating where the mud fluid was placed and the method or methods used in introducing it into the hole. If cement or other plugs were used, state the character of same and depth placed, from feet to feet for each plug set.

Filled hole with heavy mud from 3700' to 240'.
Set plug at 240'. Pumped in 95 sacks of cement
through drill pipe by Halliburton, filled to top
of hole and into cellar.

RECEIVED
STATE CORPORATION COMMISSION
JUN 29 1951
WICHITA, KANSAS

(If additional description is necessary, use BACK of this sheet)
Correspondence regarding this well should be addressed to Deep Rock Oil Corporation 629-51
Address Box #429, Hutchinson, Kansas

STATE OF Kansas, COUNTY OF Reno, ss.
Jack Smith (employee of owner) or (~~owner or operator~~) of the above-described well,
being first duly sworn on oath, says: That I have knowledge of the facts, statements, and matters herein contained and the log of the above-described well as filed and that the same are true and correct. So help me God.

(Signature) Jack Smith

Box #429, Hutchinson, Kansas
(Address)

SUBSCRIBED AND SWORN to before me this 28th day of June, 1951

My Commission Expires August 2, 1953

My commission expires C. E. Eyer Notary Public.

PLUGGING
FILE SEC 20 8 200
BOOK PAGE 90 LINE 18

15-163-00329-00-00

DEEP ROCK OIL CORPORATION
Normandin Well No. 1
Section 20-8S-20W
Rooks County, Kansas

FORMATION:

Sand and clay	00'	45'
Sand and shale	45'	1360'
Shale and broken lime	1360'	1660'
Anhydrite	1660'	2000'
Shale and lime	2000'	2370'
Broken lime	2370'	2430'
Lime and shale	2430'	2560'
Broken lime and shale	2560'	2795'
Shale	2795'	2915'
Shale and broken lime	2915'	3045'
Shale and lime	3045'	3350'
Lime	3350'	3462'
Lime and shale	3462'	3510'
Lime	3510'	3440'
Lime and shale	3440'	3690'
Lime	3690'	3700'
Total Depth		3700'.

RECORDED
STATE CORP. DIVISION

JUN 29 1951

CONSERVATION DIVISION
Wichita, Kansas

629-51

PLUGGING
FILE SEC 20-8S-20W
BOOK PAGE 90 LINE 18