


STATE OF KANSAS  
STATE CORPORATION COMMISSION

WELL PLUGGING RECORD

Give All Information Completely  
Make Required Affidavit  
Mail or Deliver Report to  
Conservation Division  
State Corporation Comm.  
245 North Water  
Wichita, KS 67202

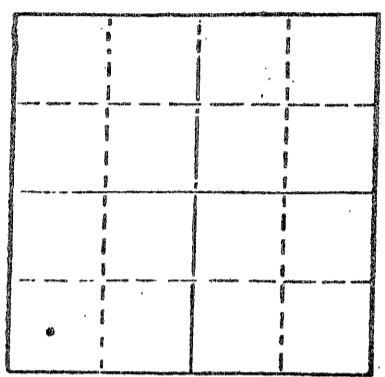

Locate well correctly on above Section Plat

Rocks \_\_\_\_\_ County. Sec. 22 Twp. 8S Rge. 20 E/W  
Location as "NE/CNW $\frac{1}{4}$ SW $\frac{1}{4}$ " or footage from lines  
C SW SW  
Lease Owner Thornton E. Anderson  
Lease Name Kuehnl Well No. 1  
Office Address 1055 Three Park Central, Denver, Colo.  
Character of Well (Completed as Oil, Gas or Dry Hole) 80202  
oil  
Date Well completed December 23 19 79  
Application for plugging filed November 17 19 80  
Application for plugging approved \_\_\_\_\_ 19 \_\_\_\_\_  
Plugging commenced November 20 19 80  
Plugging completed December 12 19 80  
Reason for abandonment of well or producing formation  
depleted  
If a producing well is abandoned, date of last production  
19 \_\_\_\_\_

Was permission obtained from the Conservation Division or  
its agents before plugging was commenced? yes  
Name of Conservation Agent who supervised plugging of this well Marion Schmidt  
Producing formation \_\_\_\_\_ Depth to top \_\_\_\_\_ Bottom \_\_\_\_\_ Total Depth of Well 3544'  
Show depth and thickness of all water, oil and gas formations.

OIL, GAS OR WATER RECORDS

CASING RECORD

FORMATION	CONTENT	FROM	TO	SIZE	PUT IN	PULLED OUT
		0	246'	8 5/8"	246'	none
			3544'	4 1/2"	3544'	2139.75

Describe in detail the manner in which the well was plugged, indicating where the mud fluid was placed and the method or methods used in introducing it into the hold. If cement or other plugs were used, state the character of same and depth placed, from \_\_\_\_\_ feet to \_\_\_\_\_ feet for each plug set.

Sanded back to 3470' and dumped 4 sacks of cement.

Allied Cementing, Inc. plugged well pumping in 5 sacks of hulls, 19 sacks of gel and 140 sacks of cement.

STATE RECEIVED  
CONSERVATION DIVISION  
Wichita, Kansas  
DEC 16 1980  
12-16-80

(If additional description is necessary, use BACK of this sheet)

Name of Plugging Contractor Pipe Recovery Company  
Box 486, Ellinwood, Kansas 67526


STATE OF KANSAS COUNTY OF BARTON  
Evelyn Roth (employee of owner) or (owner or operator)

of the above-described well, being first duly sworn on oath, says: That I have knowledge of the facts, statements, and matters herein contained and the log of the above-described well as filed and that the same are true and correct. So help me God.

(Signature) Evelyn Roth  
Ellinwood, Kansas 67526  
(Address)

SUBSCRIBED AND SWORN TO before me this 15th day of December, 19 80

My commission expires

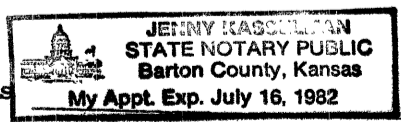

Jenny Kasselmann  
Notary Public.