

STATE OF KANSAS
STATE CORPORATION COMMISSION


15-163-21921-00-00

WELL PLUGGING RECORD

Give All Information Completely
Make Required Affidavit
Mail or Deliver Report to
Conservation Division
State Corporation Comm.
245 North Water
Wichita, KS 67202

Rooks County. Sec. 24 Twp. 8S Rge. 20W E/W
Location as "NE/CNW $\frac{1}{2}$ /SW $\frac{1}{2}$ " or footage from lines
NE SE SE

Lease Owner F & M OIL CO., INC.
Lease Name Berland "A" Well No. 1
Office Address 422 Union Center, Wichita, Ks. 67202
Character of Well (Completed as Oil, Gas or Dry Hole)
Dry Hole

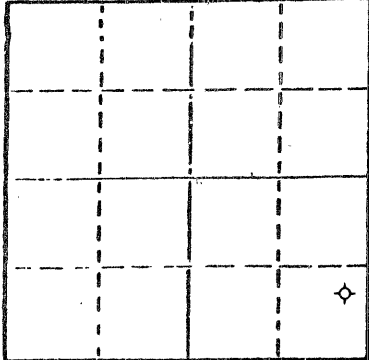

Locate well correctly on above
Section Plat

Date Well completed June 27, 1983
Application for plugging filed June 27, 1983
Application for plugging approved June 27, 1983
Plugging commenced June 27, 1983
Plugging completed June 27, 1983

Reason for abandonment of well or producing formation
Dry Hole
If a producing well is abandoned, date of last production
19

Was permission obtained from the Conservation Division or
its agents before plugging was commenced? Yes

Name of Conservation Agent who supervised plugging of this well Marion Schmidt
Producing formation Depth to top Bottom Total Depth of Well 3540'
Show depth and thickness of all water, oil and gas formations.

OIL, GAS OR WATER RECORDS

CASING RECORD

FORMATION	CONTENT	FROM	TO	SIZE	PUT IN	PULLED OUT

Describe in detail the manner in which the well was plugged, indicating where the mud fluid
was placed and the method or methods used in introducing it into the hold. If cement or other
plugs were used, state the character of same and depth placed, from feet to
feet for each plug set.

Set 1st plug @ 3500' w/25 sxs
Set 2nd plug @ 1350' w/25 sxs
Set 3rd plug @ 810' w/100 sxs
Set 4th plug @ 235' w/40 sxs
Set 5th plug @ 40' w/10 sxs
10 sxs in the rat hole,
50/50 posmix, 4% gel, 2% CC
plug down @ 9:30 PM 6-27-83

(If additional description is necessary, use BACK of this sheet)

Name of Plugging Contractor Union Drilling Co., Inc.

STATE OF Kansas COUNTY OF Sedgwick, ss.
R. D. Messinger (employee of owner) or (owner or operator)
of the above-described well, being first duly sworn on oath, says: That I have knowledge of
the facts, statements, and matters herein contained and the log of the above-described well
as filed and that the same are true and correct. So help me God.

(Signature) [Signature]
422 Union Center, Wichita, Kansas 67202
(Address)

SUBSCRIBED AND SWORN TO before me this 12th day of July, 1983

[Signature]
Shirley A. Gallegos Notary Public.

My commission expires 12-24-84



RECEIVED
STATE CORPORATION COMMISSION

JUL 18 1983

CONSERVATION DIVISION
Wichita, Kansas

7-18-83

15-163-21921-00-00

CONTRACTOR'S WELL LOG

OPERATOR:	F & M OIL CO., INC.
CONTRACTOR:	Union Drilling Co., Inc.
LEASE NAME:	Berland "A" #1
LOCATION:	NE SE SE Section 24-8S-20W Rooks County, Kansas
COMMENCED:	June 18, 1983
COMPLETED:	June 27, 1983

0	3540'	Lime & Shale	Set 8-5/8" @ 254' w/165 sxs
3540'		RTD	common cement, 2% gel, 3% CC

We certify that the above foregoing is a true and correct copy of the log on the Berland "A" #1, NE SE SE Section 24-8S-20W, Rooks County, Kansas.

Union Drilling Co., Inc.

R. D. Messinger
 R. D. Messinger

STATE OF KANSAS)
) SS
 COUNTY OF SEDGWICK)

Subscribed and sworn to before me, a Notary Public, in and for the aforesaid County and State as of this 12th day of July, 1983.

My appointment expires:

12-24-84

Shirley A. Gallegos
 Shirley A. Gallegos
 Notary Public



RECEIVED
 STATE CORPORATION COMMISSION
 7-18-83
 JUL 18 1983
 CONSERVATION DIVISION
 Wichita, Kansas