


STATE OF KANSAS  
STATE CORPORATION COMMISSION

Give All Information Completely  
Make Required Affidavit  
Mail or Deliver Report to:  
Conservation Division  
State Corporation Commission  
800 Bitting Building  
Wichita, Kansas

15-163-00363-00-00  
WELL PLUGGING RECORD

NORTH

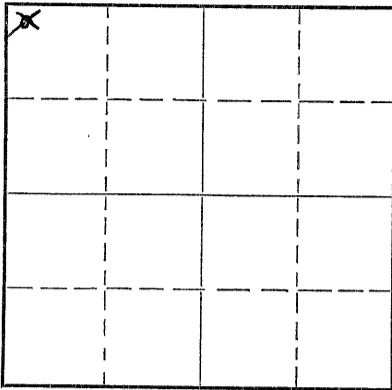

Locate well correctly on above Section Plat

Rocks \_\_\_\_\_ County. Sec. 26 Twp. 8 Rge. 20 ~~W~~ W (W)  
Location as "NE/CNW $\frac{1}{4}$ SW $\frac{1}{4}$ " or footage from lines NW NW NW  
Lease Owner DEEP ROCK OIL CORPORATION  
Lease Name Hinkhouse Well No. 1  
Office Address Box #1051, Tulsa, Oklahoma  
Character of Well (completed as Oil, Gas or Dry Hole) Dry Hole  
Date well completed May 19 19 51  
Application for plugging filed May 23 19 51  
Application for plugging approved May 21 19 51  
Plugging commenced May 19 19 51  
Plugging completed May 19 19 51  
Reason for abandonment of well or producing formation Dry Hole

If a producing well is abandoned, date of last production \_\_\_\_\_ 19\_\_\_\_\_  
Was permission obtained from the Conservation Division or its agents before plugging was commenced? Yes, permission obtained by telephone from Mr. Petty.

Name of Conservation Agent who supervised plugging of this well Mr. Eldon Petty  
Producing formation Arbuckle Depth to top 3573' Bottom 3582' Total Depth of Well 3582' Feet  
Show depth and thickness of all water, oil and gas formations.

OIL, GAS OR WATER RECORDS

CASING RECORD

Formation	Content	From	To	Size	Put In	Pulled Out
				<u>8-5/8"</u>	<u>734'</u>	<u>None</u>

Describe in detail the manner in which the well was plugged, indicating where the mud fluid was placed and the method or methods used in introducing it into the hole. If cement or other plugs were used, state the character of same and depth placed, from \_\_\_\_\_ feet to \_\_\_\_\_ feet for each plug set.

Filled hole with heavy mud from 3582' to 260'. Set wood plug and 20' rock bridge. Put in 25 sacks cement, filled up to 200'. Put in heavy mud up to 60'. Set wood plug and 20' rock bridge. Put in 15 sacks cement, filled to top of hole and into bottom of cellar.

(If additional description is necessary, use BACK of this sheet)

Correspondence regarding this well should be addressed to Deep Rock Oil Corporation  
Address Box #429, Hutchinson, Kansas

STATE OF Kansas, COUNTY OF Reno, ss.

Jack Smith (employee of owner) or owner/proprietor of the above-described well, being first duly sworn on oath, says: That I have knowledge of the facts, statements, and matters herein contained and the log of the above-described well as filed and that the same are true and correct. So help me God.

(Signature) Jack Smith  
Box #429, Hutchinson, Kansas (Address)

SUBSCRIBED AND SWORN to before me this 73rd day of May, 19 51

My commission expires 8.23.54  
Barbara Williams Notary Public.

PLUGGING  
FILE SEC 26 8 20  
BOOK PAGE 83 LINE 26

RECEIVED  
STATE CORPORATION COMMISSION  
JUN - 2 1951  
CONSERVATION DIVISION  
Wichita, Kansas

Hinkhouse Well No. 1  
Section 26-8S-20W  
Rooks County, Kansas

15-163-00363-00-00

FORMATION:

Surface clay, lime and sand	00'	166'
Broken lime and blue shale	166'	385'
Sand and Shale	385'	650'
Shale	650'	654'
Sand	654'	720'
Shale	720'	825'
Redbed	825'	870'
Sand	870'	950'
Shale and Shells	950'	1100'
Sand	1100'	1310'
Shale and Lime	1310'	1590'
Sand and shale	1590'	1629'
Anhydrite	1629'	1700'
Shale	1700'	1850'
Shale and broken lime	1850'	2030'
Lime and shale	2030'	2590'
Shale and broken lime	2590'	2780'
Shale	2780'	2895'
Shale and broken lime	2895'	3005'
Lime	3005'	3582'
Total Depth		3582'

RECEIVED  
STATE CORPORATION COMMISSION  
JUN - 2 1951  
CONSERVATION DIVISION  
Wichita, Kansas  
6-2-51

PLUGGING  
FILE SEC. 26-8-20W  
BOOK PAGE 23 LINE 26