

15-163-01059-0600

STATE OF KANSAS
STATE CORPORATION COMMISSION


Give All Information Completely
Make Required Affidavit
Mail or Deliver Report to:
Conservation Division
State Corporation Commission
1101 No. Broadway
Wichita, Kansas

WELL PLUGGING RECORD

Rooks County, Sec. 26 Twp. 8 Rge. (E) 20 (W)

Location as "NE/CNW/SW" or footage from lines SE NE SW
Lease Owner Graybol Oil Corporation
Lease Name Hinkhouse Well No. 1
Office Address 2200 National Bank of Tulsa Bldg., Tulsa, Oklahoma
Character of Well (completed as Oil, Gas or Dry Hole) Dry
Date well completed June 30 19 62
Application for plugging filed July 2 19 62
Application for plugging approved July 3 19 62
Plugging commenced June 30 19 62
Plugging completed June 30 19 62
Reason for abandonment of well or producing formation Dry Hole

NORTH

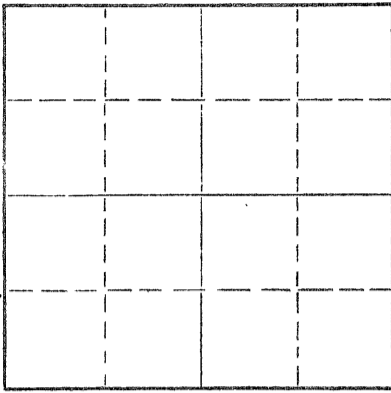

Locate well correctly on above
Section Plat

If a producing well is abandoned, date of last production 19
Was permission obtained from the Conservation Division or its agents before plugging was commenced? Yes

Name of Conservation Agent who supervised plugging of this well Eldon Petty
Producing formation None Depth to top Bottom Total Depth of Well 3667 Feet
Show depth and thickness of all water, oil and gas formations.

OIL, GAS OR WATER RECORDS

CASING RECORD

FORMATION	CONTENT	FROM	TO	SIZE	PUT IN	PULLED OUT
Lansing	Saltwater	3289	3506	8 5/8"	194'	None
Arbuckle	Saltwater	3599	3667			

Describe in detail the manner in which the well was plugged, indicating where the mud fluid was placed and the method or methods used in introducing it into the hole. If cement or other plugs were used, state the character of same and depth placed, from feet to feet for each plug set.

Filled hole with heavy mud-laden fluid. Pumped 20 sacks cement through drill pipe @ 550', 15 sacks cement @ 180', and 10' sacks cement in top of surface pipe.

(If additional description is necessary, use BACK of this sheet)
Name of Plugging Contractor Graybol Oil Corporation
Address

STATE OF OKLAHOMA, COUNTY OF Tulsa, ss.
Lyman C. Dennis (employee of owner) or (owner or operator) of the above-described well, being first duly sworn on oath, says: That I have knowledge of the facts, statements, and matters herein contained and the log of the above-described well as filed and that the same are true and correct. So help me God.

(Signature) Lyman C. Dennis

Tulsa, Oklahoma (Address)

SUBSCRIBED AND SWORN TO before me this 9th day of July 19 62

My commission expires October 8, 1962

RECEIVED
STATE CORPORATION COMMISSION

Notary Public. [Signature]

JUL 10 1962

7-10-62

CONSERVATION DIVISION
Wichita, Kansas

15-163-01039-00-00

Graybol Oil Corporation
No. 1 Hinkhouse SE NE SW
Contractor: Company Tools
Commenced: June 19, 1962
Production: D & A

Rooks County, Kansas
Section 26-8S-20W
Elev: G.L. 2050', D.F. 2056' K.B. 205
Completed: June 30, 1962

CASING RECORD

194' - 8 5/8" Cemented with 180 sacks

Depth	Formation
0-195	Surface
195-420	Shale and Shells
420-822	Shale and Sand
822-1470	Shale and Shells
1470-1571	Shale & Shells & Red Beds
1571-1607	Anhydrite
1607-1681	Shale and Shells
1681-2000	Shale and Anhydrite
2000-2150	Shale and Shells
2150-2236	Shale
2236-3040	Shale & Lime
3040-3065	Lime
3065-3100	Shale
3100-3122	Lime
3122-3280	Shale and Lime
3280-3290	Shale
3290-3330	Lime
3330-3405	Lime and Shale
3405-3507	Lime
3507-3552	Shale and Lime
3552-3578	Lime and Chert
3578-3600	Shale and Lime
3600-3665	Lime and Shale

Drillers T. D. 3665

Welex T. D. 3667

Electric Log Tops:
Heebner 3248
Lansing 3289
Base/KC 3496
Arbuckle 3599

I hereby certify that the above is a true and correct log of the above captioned well as taken directly from the daily drilling reports.

GRAYBOL OIL CORPORATION

By: Edward Haddad
Edward Haddad, Geologist

Subscribed and Sworn to before me this 9th day of July, 1962.

My Commission expires October 8, 1962.

Ray Lawrence
Notary Public

RECORDED
STATE CORPORATION COMMISSION

JUL 10 1962 7-10-62

CONSERVATION DIVISION
Wichita, Kansas

EH:jec