

STATE OF KANSAS  
STATE CORPORATION COMMISSION


15-163-21862-02-02

WELL PLUGGING RECORD

Give All Information Completely  
Make Required Affidavit  
Mail or Deliver Report to  
Conservation Division  
State Corporation Comm.  
245 North Water  
Wichita, KS 67202

Rooks County, Sec. 27 Twp. 8S Rge. 20W ~~XX~~/W  
Location as "NE/CNW $\frac{1}{4}$ SW $\frac{1}{4}$ " or footage from lines  
SE NW SW

Lease Owner F & M OIL CO., INC.  
Lease Name Miller "B" Well No. 1  
Office Address 422 Union Center, Wichita, Ks. 67202  
Character of Well (Completed as Oil, Gas or Dry Hole)  
Dry  
Date Well completed December 3, 1982  
Application for plugging filed December 3, 1982  
Application for plugging approved December 3, 1982  
Plugging commenced December 3, 1982  
Plugging completed December 3, 1982  
Reason for abandonment of well or producing formation

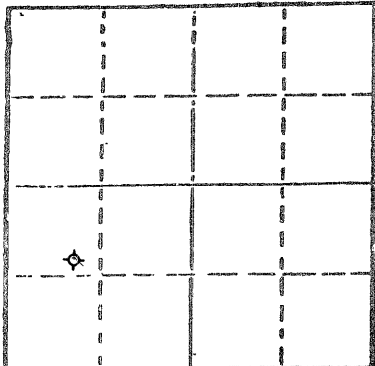

Locate well correctly on above  
Section Plot

If a producing well is abandoned, date of last production  
19

Was permission obtained from the Conservation Division or  
its agents before plugging was commenced? Yes

Name of Conservation Agent who supervised plugging of this well Marion Schmidt  
Producing formation Depth to top Bottom Total Depth of Well 3620'  
Show depth and thickness of all water, oil and gas formations.

OIL, GAS OR WATER RECORDS

CASING RECORD

FORMATION	CONTENT	FROM	TO	SIZE	PUT IN	PULLED OUT

Describe in detail the manner in which the well was plugged, indicating where the mud fluid was placed and the method or methods used in introducing it into the hold. If cement or other plugs were used, state the character of same and depth placed, from feet to feet for each plug set.

- Set 1st plug @ 1490' w/20 sxs
- Set 2nd plug @ 860' w/80 sxs
- Set 3rd plug @ 250' w/40 sxs
- 10 sxs & plug @ 40', 10 sxs in the rat hole, total of 160 sxs used, 50/50 posmix, 6% gel, 3% CC, plug down @ 9 AM 12-3-82

(If additional description is necessary, use BACK of this sheet)

Name of Plugging Contractor Union Drilling Co., Inc.


STATE OF Kansas COUNTY OF Sedgwick, ss.  
R. D. Messinger (employee of owner) or (owner or operator)  
of the above-described well, being first duly sworn on oath, says: That I have knowledge of the facts, statements, and matters herein contained and the log of the above-described well as filed and that the same are true and correct. So help me God.

(Signature) *R. D. Messinger*  
422 Union Center, Wichita, Kansas 67202  
(Address)

SUBSCRIBED AND SWORN TO before me this 8th day of December, 1982

*Shirley A. Gallegos*  
Notary Public.

Shirley A. Gallegos  
STATE CORPORATION COMMISSION

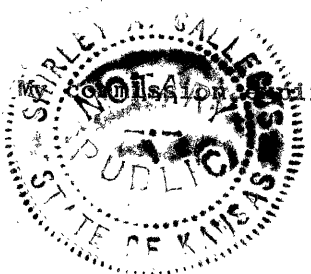

RECEIVED  
DEC 16 1982  
CONSERVATION DIVISION  
Wichita, Kansas  
12/16/82

15-163-21862-00-50

CONTRACTOR'S WELL LOG

OPERATOR:	F & M OIL CO., INC.
CONTRACTOR:	Union Drilling Co., Inc.
LEASE NAME:	Miller "B" #1
LOCATION:	SE NW SW Section 27-8S-20W Rooks County, Kansas
COMMENCED:	November 26, 1982
COMPLETED:	December 03, 1982

0	581	Shale	Set 8-5/8" @ 251' w/180 sxs common
581	1738	Sand	cement 2% gel, 3% CC
1738	3620	Lime & Shale	
3620		RTD	

We certify that the above foregoing is a true and correct copy of the log on the Miller "B" #1, SE NW SW Section 27-8S-20W, Rooks County, Kansas.

Union Drilling Co., Inc.

*R. D. Messinger*  
 R. D. Messinger

STATE OF KANSAS     )  
                                   ) SS  
 COUNTY OF SEDGWICK )

Subscribed and sworn to before me, a Notary Public in and for the aforesaid County and State as of this 7th day of December, 1982.

My appointment expires:

.....  
 12-24-84

*Shirley A. Gallegos*  
 Shirley A. Gallegos-Notary Public



RECEIVED  
 STATE CORPORATION COMMISSION  
 DEC 16 1982  
 CONSERVATION DIVISION  
 12/16/82