


Give All Information Completely
Make Required Affidavit
Mail or Deliver Report to:
Conservation Division
State Corporation Commission
800 Bitting Building
Wichita, Kansas

WELL PLUGGING RECORD

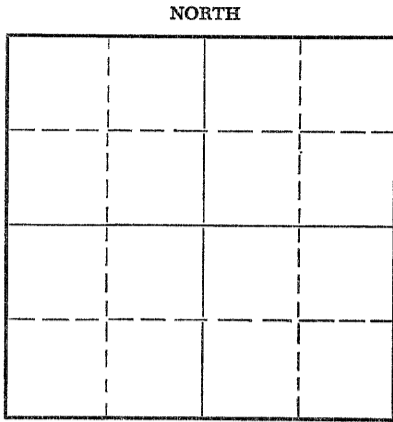

Locate well correctly on above
Section Plat

Graham County. Sec. 21 Twp. 8 Rge. (E) 21 (W)
Location as "NE/CNW/SW" or footage from lines SW 1/4 SE 1/4 NW 1/4
Lease Owner Barnett Oil Company, et al
Lease Name Brault Well No. 1
Office Address 417 First Nat'l Bank Bldg., Wichita, Kansas
Character of Well (completed as Oil, Gas or Dry Hole) Dry Hole
Date well completed June 8, 1954
Application for plugging filed June 8, 1954
Application for plugging approved June 8, 1954
Plugging commenced June 8, 1954
Plugging completed June 8, 1954
Reason for abandonment of well or producing formation Dry Hole

If a producing well is abandoned, date of last production - - - - - 1954
Was permission obtained from the Conservation Division or its agents before plugging was commenced? Yes

Name of Conservation Agent who supervised plugging of this well Eldon Petty
Producing formation _____ Depth to top _____ Bottom _____ Total Depth of Well 3713 Feet
Show depth and thickness of all water, oil and gas formations.

OIL, GAS OR WATER RECORDS

CASING RECORD

| FORMATION | CONTENT | FROM | TO | SIZE | PUT IN | PULLED OUT |
|--------------|---------|------|------|--------|--------|------------|
| Surface Pipe | | -0- | 165' | 8 5/8" | 165' | None |
| | | | | | | |
| | | | | | | |
| | | | | | | |
| | | | | | | |
| | | | | | | |
| | | | | | | |

Describe in detail the manner in which the well was plugged, indicating where the mud fluid was placed and the method or methods used in introducing it into the hole. If cement or other plugs were used, state the character of same and depth placed, from _____ feet to _____ feet for each plug set.

Filled hole with heavy mud from 3713 feet to 160 feet. Set wooden plug at 160 feet and filled surface casing with 1/2 sack of hulls and 15 sacks of cement to 113 feet. Filled casing with heavy mud from 113 feet to 40 feet. Set wooden plug at 40 feet and filled casing with 1/2 sack of hulls and 10 sacks of cement to bottom of cellar.

(If additional description is necessary, use BACK of this sheet)
Name of Plugging Contractor Barnett Drilling, Inc.
Address 623 First Nat'l Bank Bldg., Wichita, Kansas

STATE OF Kansas, COUNTY OF Sedgwick, ss.
W. R. Hunter (employee of owner) or ~~owner or operator~~ of the above-described well, being first duly sworn on oath, says: That I have knowledge of the facts, statements, and matters herein contained and the log of the above-described well as filed and that the same are true and correct. So help me God.

(Signature) W. R. Hunter
417 First Nat'l Bank Bldg., Wichita, Kansas
(Address)

SUBSCRIBED AND SWORN TO before me this 9th day of June, 1954

My commission expires February 27, 1956.
Mildred J. Willis Notary Public.

24-7368-5 3-53-20M
PLUGGING
FILE SEC 21 T. 8 R. 21W
BOOK PAGE 40 LINE 30

RECEIVED
STATE CORPORATION COMMISSION
JUN 15 1954 6-15-54
CONSERVATION DIVISION
Wichita, Kansas

15-065-00435-06-00

BARNETT OIL COMPANY, ET AL
LOG OF BRAULT WELL NO. 1
SW $\frac{1}{4}$ SE $\frac{1}{4}$ NW $\frac{1}{4}$ SECTION 21-8S-21W
GRAHAM COUNTY, KANSAS


DATE COMMENCED: May 30, 1954

DATE COMPLETED: June 8, 1954

| <u>Formation</u> | <u>From</u> | <u>To</u> | <u>Remarks</u> |
|------------------------|-------------|-----------|----------------|
| Surface Clay and Shale | 0 | 50 | |
| Sand | 50 | 60 | |
| Shale | 60 | 105 | |
| Sand | 105 | 115 | |
| Shale and Shells | 115 | 165 | |
| Shale | 165 | 225 | |
| Shale and Shells | 225 | 550 | |
| Sand | 550 | 665 | |
| Shale and Shells | 665 | 1100 | |
| Sand | 1100 | 1140 | |
| Shale and Sand | 1140 | 1490 | |
| Shale | 1490 | 1630 | |
| Anhydrite | 1630 | 1663 | |
| Shale | 1663 | 1710 | |
| Shale and Shells | 1710 | 2010 | |
| Shale | 2010 | 2290 | |
| Lime and Shale | 2290 | 2420 | |
| Lime | 2420 | 2480 | |
| Lime and Shale | 2480 | 2645 | |
| Lime | 2645 | 2830 | |
| Shale and Lime Shells | 2830 | 2945 | |
| Lime and Shale | 2945 | 3170 | |
| Lime | 3170 | 3575 | |
| Lime and Shale | 3575 | 3620 | |
| Shale | 3620 | 3713 | |
| Total Depth | | 3713 | |

Set 8 5/8", 21# surface casing at 165';
 cemented with 125 sacks of cement.

Dry and Abandoned.

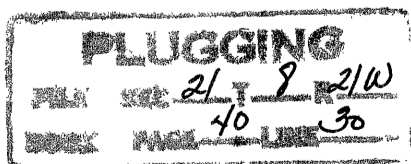

6-15-54

RECEIVED
 STATE CORPORATION COMMISSION
 JUN 15 1954
 CONSERVATION DIVISION
 Wichita, Kansas